

Name James P. McCarthy

Service No. ~~104~~ 922

Address

201 Follen Rd.

Location #201 Lot 12 - Follen Road

#5639

Kind of Pipe

Size

Size of Main

Repair—Renewal—New Service

Location

Date
1941

Material

Amount

Total

Date

Amount

Nov. 22

3 hrs. @ 50¢ 1 50

43 " @ 55¢ 23 65

2 " @ 60¢ 1 20

10% Overhead

68' 1" Copper tubing @ 22¢

1 1" C x 3/4" I.S.& W.

1 1" C. Union (3 part)

2 hrs. trucking @ 75¢

Trench repairs

26 35

2 63

14 96

2 50

1 25

1 50

2 78

51 97

September 1941

Deposited

55 00

Dec 30 1941

Refund

3 03

51 97

Labor

DATE _____

TOWN OF LEXINGTON—BOARD OF PUBLIC WORKS

WATER DIVISION

The undersigned applies for a supply of water at No. _____ St. and hereby agrees to comply with the rules and regulations as now, or at any future time, established by the Board of Selectmen.

Am't. of Estimate \$ _____


Owner _____

Am't. Paid \$ _____

Address _____

Builder _____

Sketch of Service Here

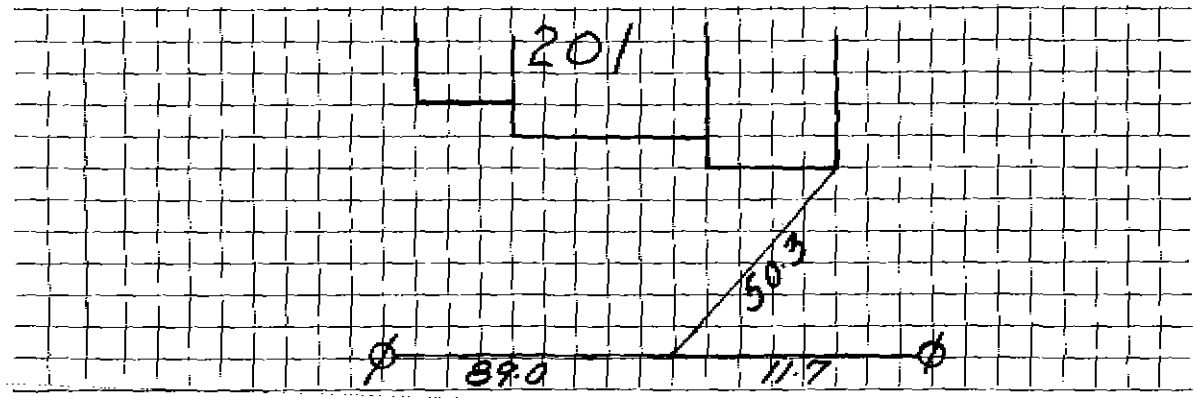

Connection made in _____ Street. Work completed _____ 19__

Remarks: