

Name Percy Catton

Service No. ~~102~~ 923

Address 57 Grozier Road, Cambridge  
#203 Follen Road

#866

Location 203 Follen Road, Lexington

Kind of Pipe

Size

Size of Main

Repair—Renewal—New Service

Location

Date  
1941

Material

Amount

Total

Date

Amount

Nov. 8,

28 hrs. @ 50¢

14 00

25 40

October 17, 1941

Deposited

55 00

19 hrs. @ 60¢

11 40

Dec 30, 1941

Refund

10 21

10% Overhead

2 54

44 79

49' 3/4" Copper tubing @ 19¢

9 31

1' 3/4" C.x 1/2" I.S.&W.

2 50

2 hrs. trucking @ 75¢

1 50

Trench repairs

3 54

44 79

Labor

DATE Oct. 14, 1941

TOWN OF LEXINGTON—BOARD OF PUBLIC WORKS  
WATER DIVISION

The undersigned applies for a supply of water at No. 203 Follen Road St. and hereby agrees to comply with the rules and regulations as now, or at any future time, established by the Board of Selectmen.

Am't. of Estimate \$ 55.00 (Town)  
22.00 (Owner)

Owner Edwing F. Cotton


Am't. Paid \$ \_\_\_\_\_

Address 57 Grozier Road

Builder Building Maintenance Co. Malden, Mass

Cambridge Mass

Sketch of Service Here

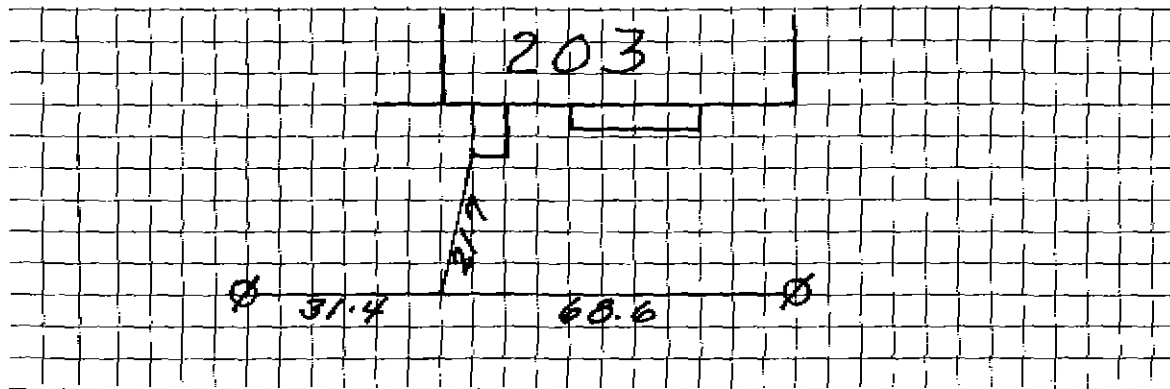

Connection made in \_\_\_\_\_ Street.

Work completed \_\_\_\_\_ 19

Remarks: