

#4977

WATER SERVICE RECORD

Name Alfred J. Parece

Service No. 311 (1954)

Address 204 Follen Road

Location

Repair ~~XXXXXX~~ New Service

*Com - 4-11-55*


Date	Material	Amount	Total	Date	Amount
3/3/55	Labor	1 85		12-21-54	Deposited 25 00
	10% overhead	19	2 04	4-11-55	Refunded 01
	52' - 3/4" copper tubing@.35	18 20			<u>NON CHARGE</u> 24 99
	1 - 3/4"C x 1/2 L.W.R. stop & waste	4 00	3/3/55	Labor	1 85
	1 hr. trucking	75	32' - 3/4" copper tubing@.35		11 20
		24 99	1 - 3/4"C. corp-cock		4 33
			1 - 3/4"C. curb-cock		4 67
			1 box and rod		3 90
			1 - 1/2 straight tail pc.		50
			1 - 1/2 offset tail pc.		50
			2 2/3 hrs. Littlefield shovel@7.50		20 00
			1 hr. trucking		75
					<u>47 70</u>

DATE \_\_\_\_\_

TOWN OF LEXINGTON — BOARD OF PUBLIC WORKS

**WATER DIVISION**

Sketch of Service Here

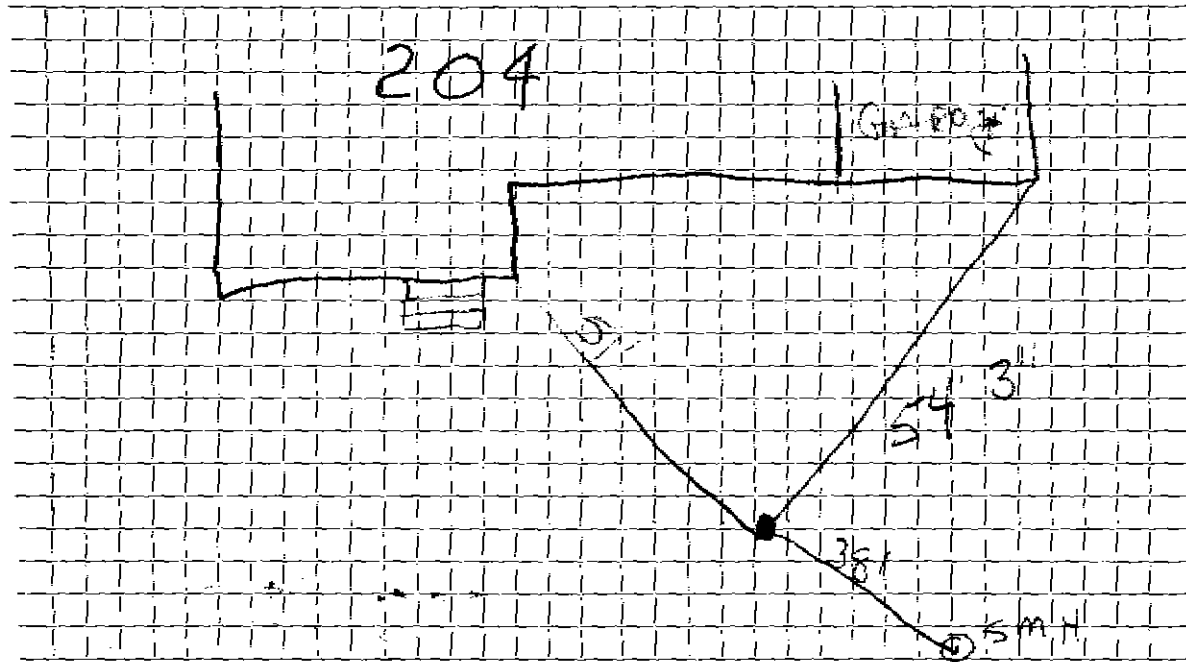

Connection made in ..... Street. Work completed .....

Remarks: .....

.....

.....