



Name **Mary Lovering Holman**
 Address **39 Winsor Avenue, Watertown, Mass.**
205 Fallen Rd.

Service No. **52924** *#3333*

Location **205 Follen Rd.,**

Kind of Pipe _____ Size _____ Size of Main _____
 Repair—Renewal—New Service _____ Location _____

Date 1940	Material	Amount	Total	Date	Amount
Sept. 17	8 hrs. @ 60¢		4 80	September 17, 1940	25 00
<i>Com 9/30/40</i>	10% Overhead		48	October 2, 1940	1 02
	70' 1" Copper tubing @ 21¢		14 70		
	1 1" O x 3/4" I. S. & W.		2 25		
	1 1" C Union (3 part)		1 00		
	1 hrs. trucking @ 75¢		75		
			<hr/> 23 98		<hr/> 25 98
	Labor				

Hadley Press, Inc., Lexington

DATE Dec 9, 1940

TOWN OF LEXINGTON - BOARD OF PUBLIC WORKS
WATER DIVISION

The undersigned applies for a supply of water at No. 205 Follen St. and hereby agrees to comply with the rules and regulations as now, or at any future time, established by the Board of Selectmen.

Am't. of Estimate \$


Owner Mary Louering Holman

Am't. Paid \$

Address 39 Winsor Ave
Watertown

Builder

Sketch of Service Here

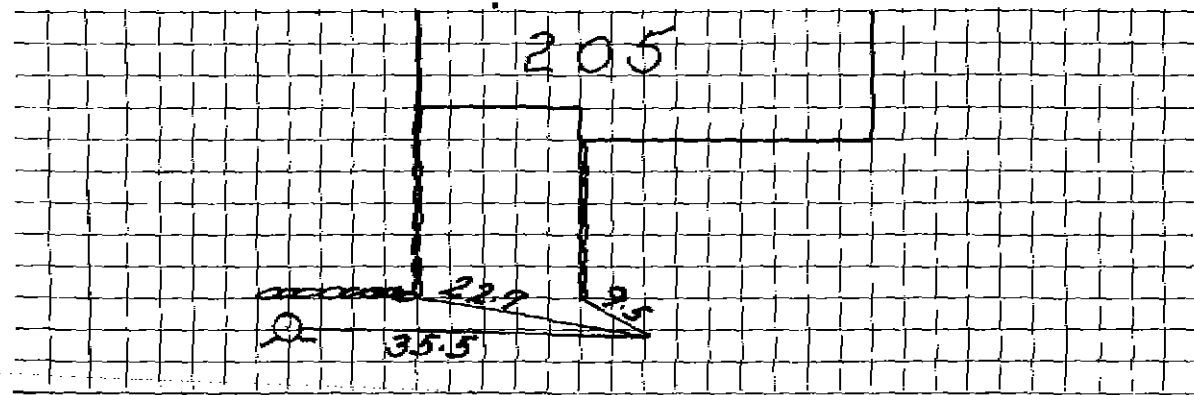

Connection made in _____ Street. Work completed _____ 19

Remarks: