

Name N. A. Colbert
 Address 206 Follen Road
 Lexington, Mass.

Service No. 91
 #1892-1893

Location 206 Follen Road

Kind of Pipe Size Size of Main
~~Repair~~ ~~Renewal~~ - New Service Com. 8-23-48 Location

Date	Material	Amount	Total	Date	Amount
June 23, '48	Labor	2 10	2 10	June 18 '48	50 00
	10% Overhead		21	Aug 20 '48	8 52
	17' - 3/4" Copper Tubing @ .255	4 34	25 44		44 43
	1 - 3/4" C x 3/4" I.W.E. S & W	3 15	29 59	June 23, '48	6 30
	Trucking 1 hr. @ .75	0 75	30 34		9 44
	Patching 27 x 3	27 00	57 34		3 00
8/30/76	1 3/4-3 PART UNION	4.69	62 03		3 68
	Trench dug by owner.				3 55
	Labor				30
					30
					24 50
					75
					51 82

Hadley Press, Inc., Lexington

DATE _____

TOWN OF LEXINGTON—BOARD OF PUBLIC WORKS

WATER DIVISION

The undersigned applies for a supply of water at No. _____ St. and hereby agrees to comply with the rules and regulations as now, or at any future time, established by the Board of Selectmen.

Am't. of Estimate \$ _____


Owner _____

Am't. Paid \$ _____

Address _____

Builder _____

Sketch of Service Here

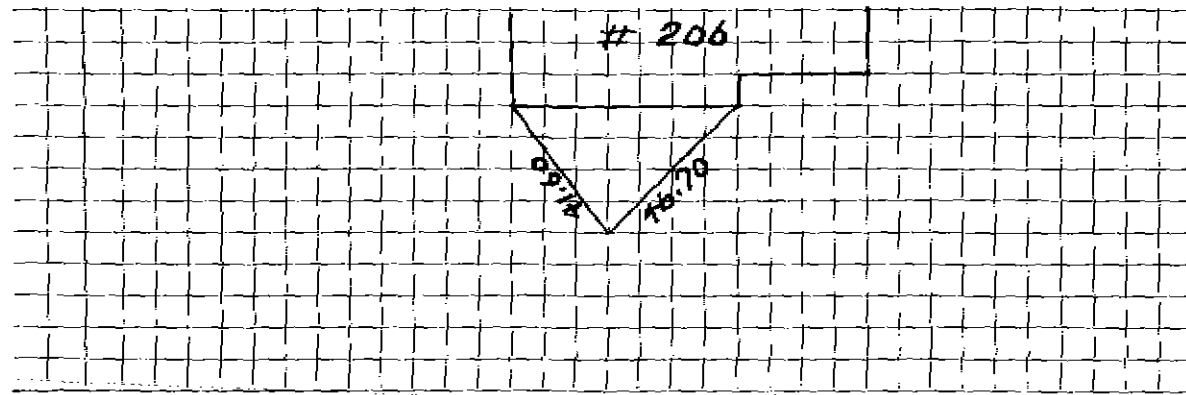

Connection made in _____ Street.

Work completed _____ 19 _____

Remarks: