

Name John R. Marques

Service No. 100

Address 207 Follen Road

#5263

Lexington

Location 207 Follen Road

Kind of Pipe

Size

Size of Main

~~Repair-Removal~~ - New Service

Com. 7-3-50

Location

Date	Material	Amount	Total	Date	Amount
June 7 '50	Labor	2 30	2 30	May 16 '50	100 00
June 8 '50	Labor	8 60	8 60	July 20 '50	30 40
	10% Overhead		1 09		69 60
	66' - 3/4" Copper Tubing @ 23¢	15 18	15 18		No Charge
	1 - 3/4"C x 1/2" I.W.H. S&W	3 29	3 29	June 8 '50	9 00
	1 - 3/4"C x 3/4"C Union (3 pts)	1 39	1 39	18' 3/4"C Copper Tubing @ 23¢	4 14
	4 hrs. Littlefield Shovel	28 00	28 00	1 - 3/4"C Corp-cock	3 15
	1 hr. Trucking		75	1 - 3/4"C x 3/4"C Curb-cock	3 85
	Patching 9 x 3		9 00	1 Box & Rod	3 35
			69 60	2 hrs. Littlefield Shovel	14 00
				1 hr. Trucking	75
	Labor				38 24

DATE _____

TOWN OF LEXINGTON - BOARD OF PUBLIC WORKS

WATER DIVISION

The undersigned applies for a supply of water at No. _____ St. and hereby agrees to comply with the rules and regulations as now, or at any future time, established by the Board of Selectmen.

Am't. of Estimate \$ _____


Owner _____

Am't. Paid \$ _____

Address _____

Builder _____

Sketch of Service Here

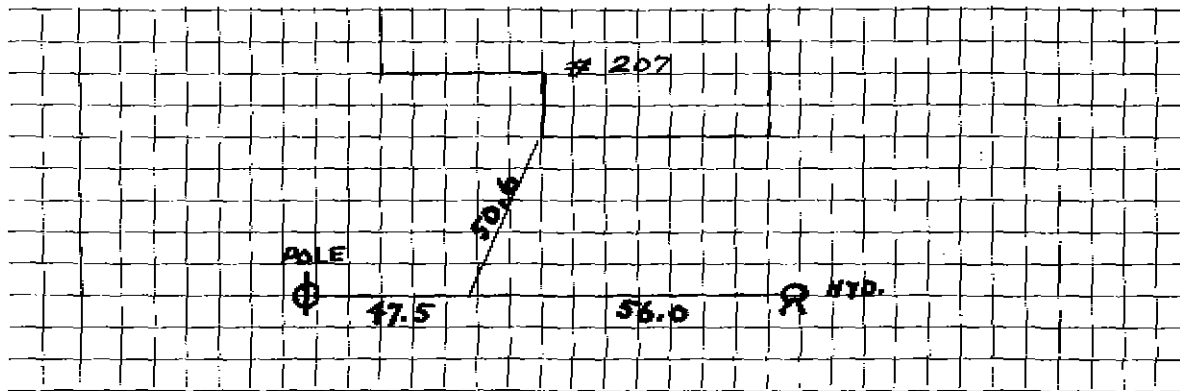

Connection made in _____ Street. Work completed _____ 19__

Remarks: