

Name Everett McCassey

Service No. 3263

Address 208 Follen Road

614

Lexington, Mass.

Location 208 Follen Road

Kind of Pipe

Size

Size of Main

~~Repair-Renewal~~ - New Service

Location

Date	Material	Amount	Total	Date	Location	Amount
May 9, '47	Labor	13 89	13 89	May 8 '47	Deposited	60 00
	10% Overhead		1 39	May 22 '47	Refunded	4 13
	47' - 3/4" Copper Tubing @.27		12 69		Non-Charge	65 87
	1 - 3/8" C x 1/2" I.W.H. S & W		3 15	May 9, '47	Labor	31 78
	Patching 24 x 3		24 00	10	"	8 87
	Trucking 1 hr. @.75		75	29' - 3/4" Copper Tubing @.27		7 83
			55 87	1 - 3/8" C Corp-cock		3 00
				1 - 3/4" C x 1/2" c Curb-cock		3 68
				1 - Box & Rod		3 35
				1 - 1/2" Straight Tail Piece		50
				1 - 1/2" Offset Tail Piece		50
				Compressor 1 hr. @1.75		1 75
				Trucking 1 hr. @.75		75
	Labor					62 01

DATE _____

TOWN OF LEXINGTON—BOARD OF PUBLIC WORKS

WATER DIVISION

The undersigned applies for a supply of water at No. _____ St. and hereby agrees to comply with the rules and regulations as now, or at any future time, established by the Board of Selectmen.

Am't. of Estimate \$ _____


Owner _____

Am't. Paid \$ _____

Address _____

Builder _____

Sketch of Service Here

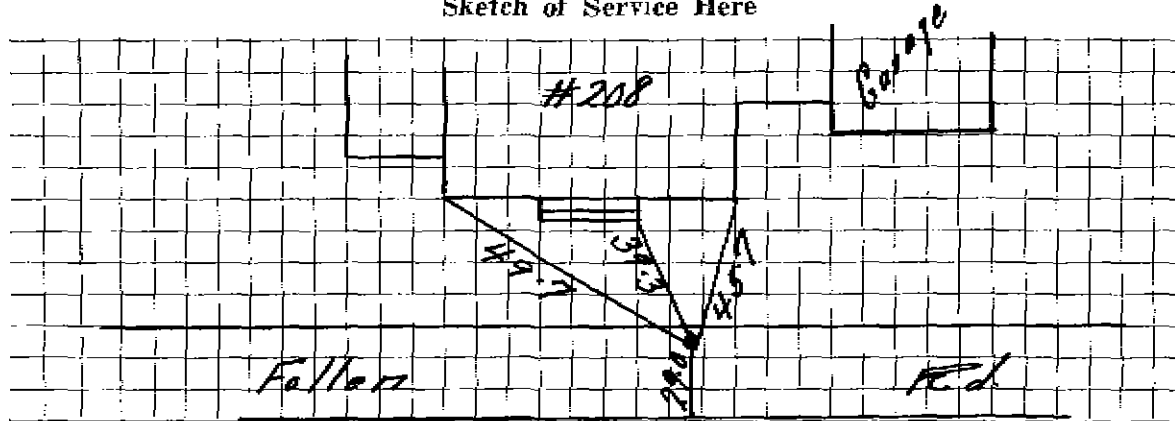

Connection made in _____ Street. Work completed _____ 19__

Remarks: