

Name Henry D. Miller

Service No. ~~17~~ 926
1530

Address 56 Forest Street
#209 Follen Road

Location 209 Follen Road

Kind of Pipe

Size

Size of Main

Repair—Renewal—New Service

Location

Date 1940	Material	Amount	Total	Date	Amount
Sept. 17	8 hrs. @ 60¢	4 80		September 17, 1940	40 00
<i>Com 9/30/40</i>	10% Overhead	48	5 28	October 2, 1940	13 20
	83' 1" Copper tubing @ 21¢		17 43		26 71
	1 1" C.x 3/4" I.S. & W.		2 25		
	1 1" C. Union (3-part)		1 00		
	1 hr. trucking @ 75¢		75		
			<u>\$26 71</u>		
	Labor				

Hadley Press, Inc., Lexington

DATE 11-11-1949

TOWN OF LEXINGTON - BOARD OF PUBLIC WORKS
WATER DIVISION *Fallon*

The undersigned applies for a supply of water at No. 209 Fallon Rd. St. and hereby agrees to comply with the rules and regulations as now, or at any future time, established by the Board of Selectmen.

Am't. of Estimate \$ _____


Owner Henry D. & Mary E. Miller

Am't. Paid \$ _____

Address 56 Forest Street,
Lexington, Mass

Builder _____

Sketch of Service Here

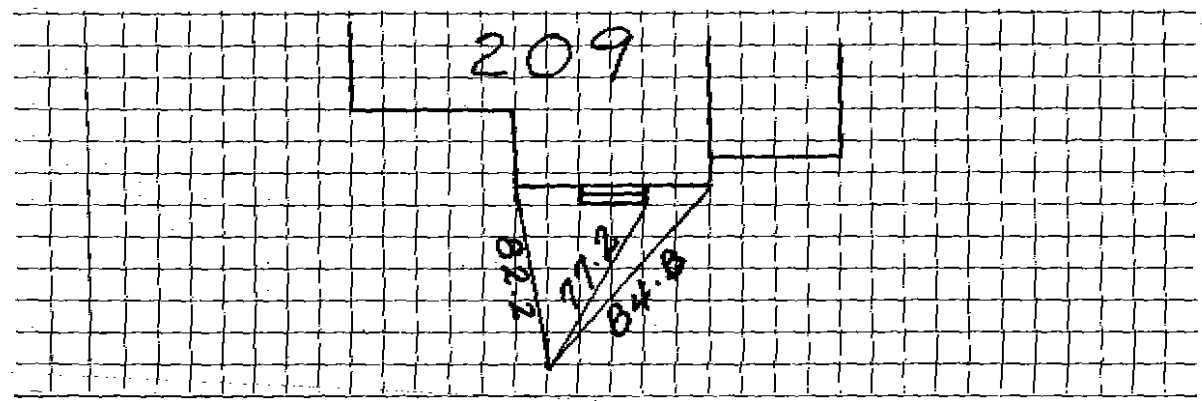

Connection made in: _____ Street, Work completed _____ 19 _____

Remarks: _____