

WATER SERVICE RECORD

Name Joseph J. Napoli

Service No. 116

Address 21 Follen Road

Location

~~Repair - Renewal - NEWS SERVICE~~ W.O. #7577

Comm 10-29-62


Date	Material	Amount	Total	Date		Amount
9-5-62	Labor	59.74		8-30-62	Deposit	150.00
	10% O.H.	5.97	65.71	10-29-62	Refund	10.16
57'	1" Copper tubing @56		31.92			139.84
1	1"X1" Wheel Handle S&W		6.96			
	16X3 Patch Driveway		16.00		NON CHARGE	
1	Hr. Trucking @3.00		3.00	9-5-62	Labor	14.72
2½	Hrs. Town Shovel @6.50		16.25			
			139.84			
				14'	1" Copper tubing @56	7.84
				1	1" C Corp Cock	7.31
				1	1" C Curb Cock	8.06
				1	Box & Rod	4.90
				1	1" Straight Tailpiece	.93
				1	1" Offset Tailpiece	.93
					18X3 Patch	18.00
					1/2 Hr. Town Shovel @6.50	3.25
					1 Hr. Trucking @3.00	3.00
						68.94

TOWN OF LEXINGTON — BOARD OF PUBLIC WORKS

WATER DIVISION

DATE

Sketch of Service Here

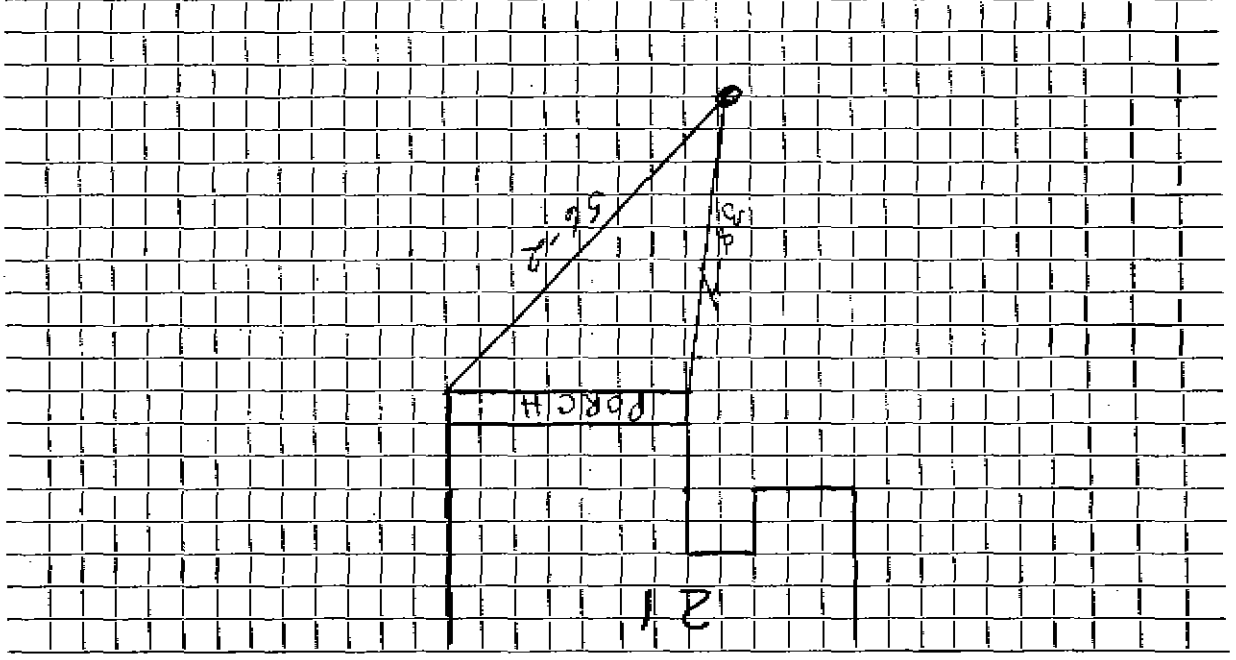

Connection made in . . . Street. Work completed. Remarks: