

#400

WATER SERVICE RECORD

Name A. J. Comeau

Service No. 23

Address 210 Follen Road

Location

~~Repair Renewal~~ - New Service

*Com. 3-22-54*


Date	Material	Amount	Total	Date	Amount
3/2/54	Labor	1 75		2-12-54	25 00
	10% overhead	18	1 93	3-22-54	17
	50' - 3/4" copper tubing@.3629	18 15			24 F3
	1 - 3/4" C x 1/2 I.W.H. stop & waste	4 00			
	1 hr. trucking	75	24 83	3/2/54	1 75
				28' + 3/4" copper tubing@.3629	10 16
				1 - 3/4" C. corp-cock	4 33
				1 - 3/4" C x 3/4" C. curb-cock	4 67
				1 box and rod	3 90
				1 - 1/2 straight tail piece	50
				1 - 1/2 offset tail piece	50
				1 hr. trucking	75
					26 56

*Deposited*  
*Refunded*  
NON CHARGE

DATE \_\_\_\_\_

TOWN OF LEXINGTON — BOARD OF PUBLIC WORKS  
WATER DIVISION

Sketch of Service Here

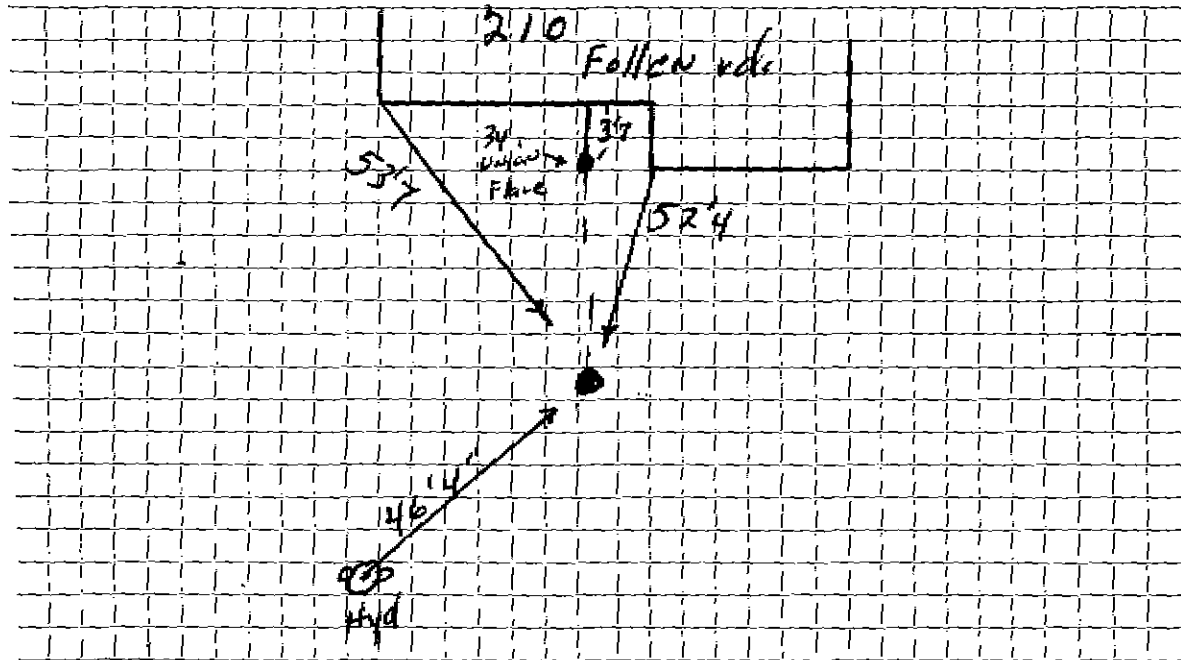

Connection made in ..... Street. Work completed .....

Remarks: .....  
.....  
.....