

WATER SERVICE RECORD

Name A. J. Comeau

Service No. 22

Address 212 Follen Road

7250

Location

~~Repair~~ ~~Change~~ ~~Water~~ ~~Service~~ New Service

Com 3-22-54


Date	Material	Amount	Total	Date	Amount
3/3/54	Labor	1 75		2-12-54	Deposited 25 00
	10% overhead	18	1 93	3-22-54	Paid (8 80)
	70' - 3/4" copper tubing@.3629		25 40		<u>NON CHARGE</u> 33 50
	1 - 3/4"C x 3/8" I.W.H. stop & waste		4 00	3/3/54	Labor 1 75
	1 - 3/4"C x 3/4"C. union		1 72	28' - 3/4" Copper tubing@.3629	10 16
	1 hr. trucking		75	1 - 3/4" C. corp-cock	4 33
			33 80	1 - 3/4" C x 3/4"C. curb-cock	4 67
				1 box and rod	3 90
				1 - 3/8" straight tail pc.	50
				1 - 1/2" offset tail pc.	50
				1 hr. trucking	75
					<u>26 56</u>

DATE _____

TOWN OF LEXINGTON — BOARD OF PUBLIC WORKS

WATER DIVISION

Sketch of Service Here

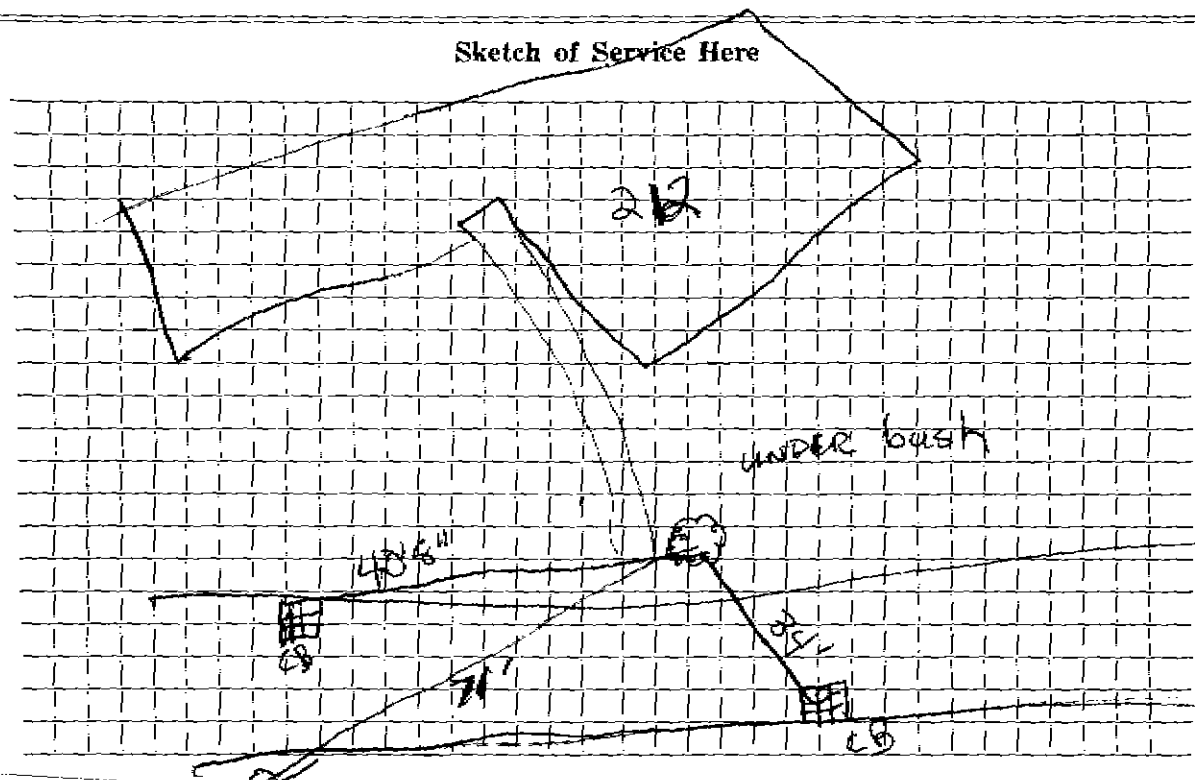

Connection made in Street. Work completed

Remarks:

.....

.....