

Name Wilbert H. Larson

Address 11 Plymouth Road, Lexington

215 Follen Road

Location

215 Follen Road

Kind of Pipe

Size

Size of Main

Repair—Renewal—New Service

Location

3151 Service No. # 927
#7012

1423

Hadley Preke, Inc., Lexington

Date	Material	Amount	Total	Date	Amount
4/5/40	22 hrs. @ 55¢	12 10		May 1, 1940	65 00
Jan 6/11/40	22 " @ 60¢	13 20		June 11, 1940	97
	2 " @ 65¢	1 30			64 03
	5 " @ 70¢	3 50	30 10		
	10% Overhead		3 01		
	56' 3/4" Copper tubing @ 17¢		9 52		
	1 3/4" Copper x 1/2" I. S. & W.		2 25		
	1 3/4" Copper Union (3 part)		90		
	Compressor, 4 hrs. @ \$3.00		12 00		
	Trucking, 3 hrs. @ 75¢		2 25		
	Trench repairs		4 00		
			64 03		
	Labor				

DATE

April 2, 1940

TOWN OF LEXINGTON—BOARD OF PUBLIC WORKS

WATER DIVISION

The undersigned applies for a supply of water at No. 215 Follen Rd. Lot 22 St. and hereby agrees to comply with the rules and regulations as now, or at any future time, established by the Board of Selectmen.

Am't. of Estimate \$ 65.00

Town digging

Owner

Hubert G. Lanson

Am't. Paid \$ _____


Address

11 Plymouth Rd.
Lexington, Mass.

Builder

Hubert G. Lanson

Sketch of Service Here

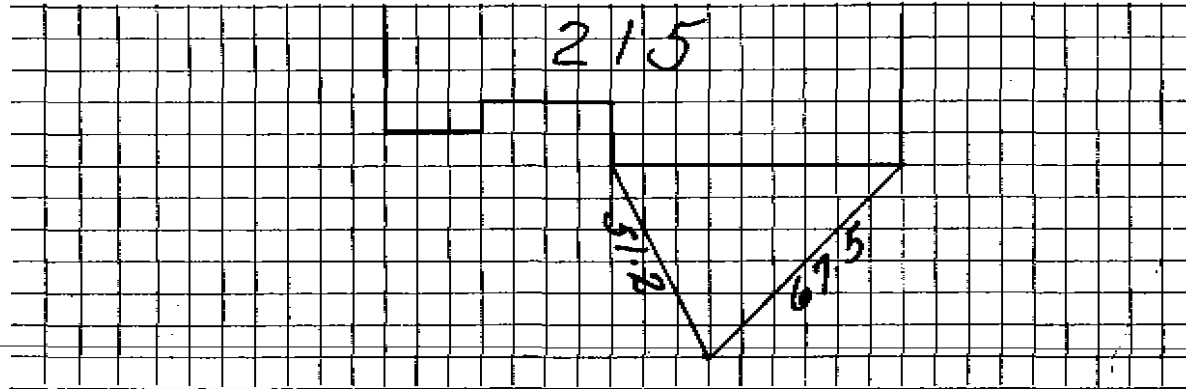

Connection made in _____ Street.

Work completed _____ 19

Remarks: