

Plumber:

Name Lester Andrews

Service No. 928

Address 1 Hill Street, Lexington

216 Follen Road

Location

216 Follen Road.

Kind of Pipe

Size

Size of Main

~~Repair~~ ~~Renewal~~ New Service

Location

Date
1940

Material

Amount

Total

Date

Amount

Nov. 6,

4 hrs. @ 60¢

2 40

November 6, 1940 Paid

41 19

Com 11/18/40

10% Overhead

24

2 64

90' 1" Copper tubing @ 21¢

18 90

1 1" Cx3/4" I.S. & W.

2 25

1 1" G. Union (3 part)

90

2 hrs. trucking @ 75¢

1 50

Trench repairs

15 00

\$41 19

11-7-40 Bill sent.

Labor

Radley Press, Inc., Lexington

DATE _____

TOWN OF LEXINGTON—BOARD OF PUBLIC WORKS

WATER DIVISION

The undersigned applies for a supply of water at No. _____ St. and hereby agrees to comply with the rules and regulations as now, or at any future time, established by the Board of Selectmen.

Am't. of Estimate \$ _____


Owner _____

Am't. Paid \$ _____

Address _____

Builder _____

Sketch of Service Here

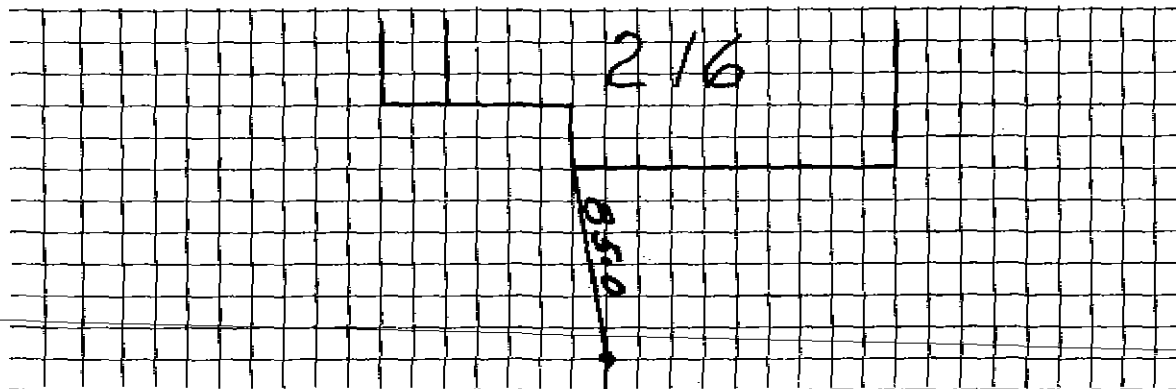

Connection made in _____ Street.

Work completed _____ 19

Remarks:

0.60
0