

Name **W. H. Larson**

#5039  
Service No. **56 929**

Address **11 Plymouth Rd., Lexington**

*217 Follen Road*

Location **217 Follen Road**

Kind of Pipe

Size

Size of Main

Repair—Renewal—New Service

Location

Date  
1940

Material

Amount

Total

Date

Amount

July 19

2 hrs. @ 60¢

1 20

*July 25, 1940 Deposited*

25.00

*Sum 9/30/40*

10% Overhead

12

*October 2, 1940 Refunded*

6.85

60' 3/4" Copper tubing @ 18¢

10 80

1 3/4" C.x 1/2" I.S. & W.

2 25

1 hr. trucking @ 75¢

75

Trench repairs

3 00

18 12

18.12

Labor

DATE July 11, 1940

TOWN OF LEXINGTON—BOARD OF PUBLIC WORKS

WATER DIVISION

The undersigned applies for a supply of water at No. 217 Follen Road (Lot #23) St. and hereby agrees to comply with the rules and regulations as now, or at any future time, established by the Board of Selectmen.

Am't. of Estimate \$ 75.00


Owner William J. Luson

Am't. Paid \$ \_\_\_\_\_

Address 11 Plymouth Rd.  
Lexington, Mass.

Builder W. J. Luson

Sketch of Service Here

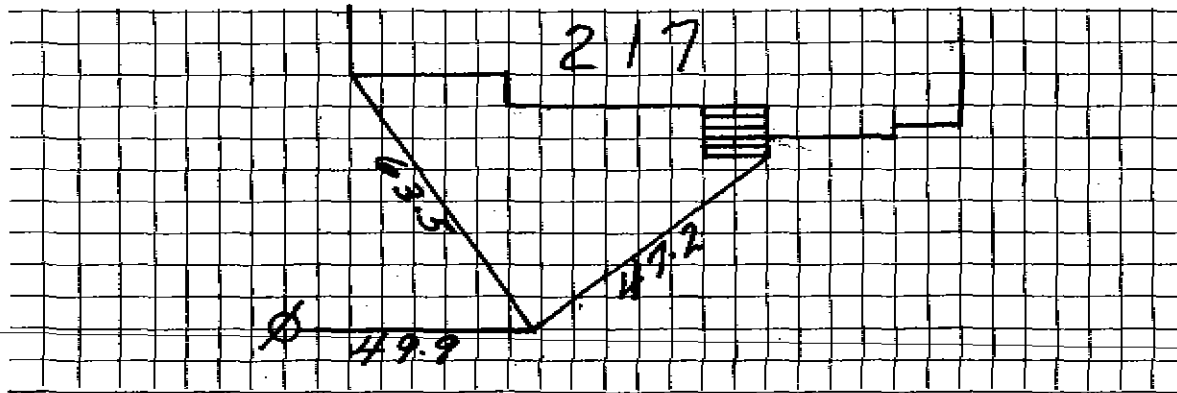

Connection made in \_\_\_\_\_ Street.

Work completed \_\_\_\_\_ 19

Remarks: