




TOWN OF LEXINGTON - BOARD OF PUBLIC WORKS  
WATER DIVISION

Date: 11/17/21

SKETCH OF SERVICE HERE

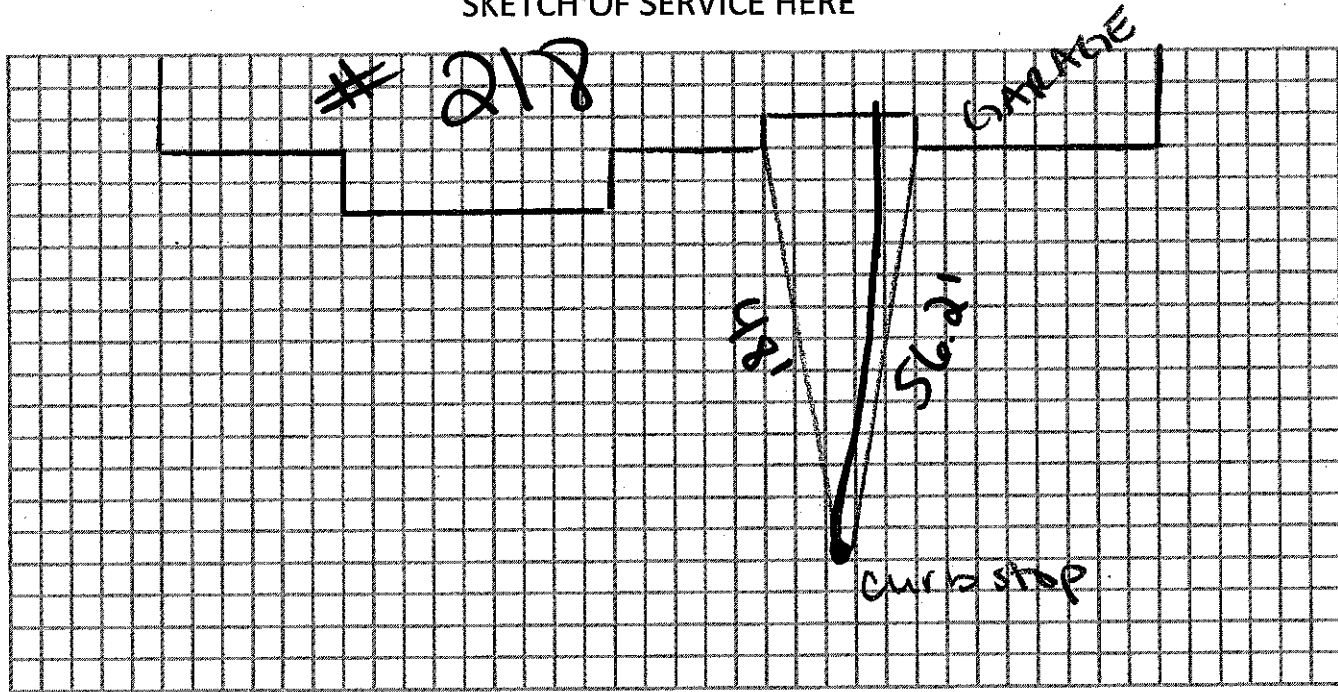

Connection made in: Follen Rd Street. Work completed:

Remarks:

60' length  
depth = 6' 7"