

Name W. H. Larson

Service No. ~~30~~ 930

Address 11 Plymouth Road, Lexington, Mass.

3023

#219 Follen Rd.

Location 219 Follen Road

#7144

Kind of Pipe

Size

Size of Main

~~Repair - Renewal~~ New Service

Location

Date  
1940

Material

Amount

Total

Date

Amount

July 24

2 hrs @ 60¢

1 20

August 2, 1940

Deposited

25.00

Sum 9/30/40

10% Overhead

12

October 2, 1940

Refunded

7.88

60' 3/4" Copper tubing @ 18¢

10 80

1 3/4" Cx 1/2" I S. & W/

2 25

1 hr. trucking @ 75¢

75

Trench repairs

2 00

17 12

17.12

Labor

DATE July 22, 1940

# TOWN OF LEXINGTON—BOARD OF PUBLIC WORKS

## WATER DIVISION

The undersigned applies for a supply of water at No. 219 St. and hereby agrees to comply with the rules and regulations as now, or at any future time, established by the Board of Selectmen.

Am't. of Estimate \$ 2.00


Owner J. B. Shaw

Am't. Paid \$ \_\_\_\_\_

Address 112

Builder \_\_\_\_\_

Sketch of Service Here

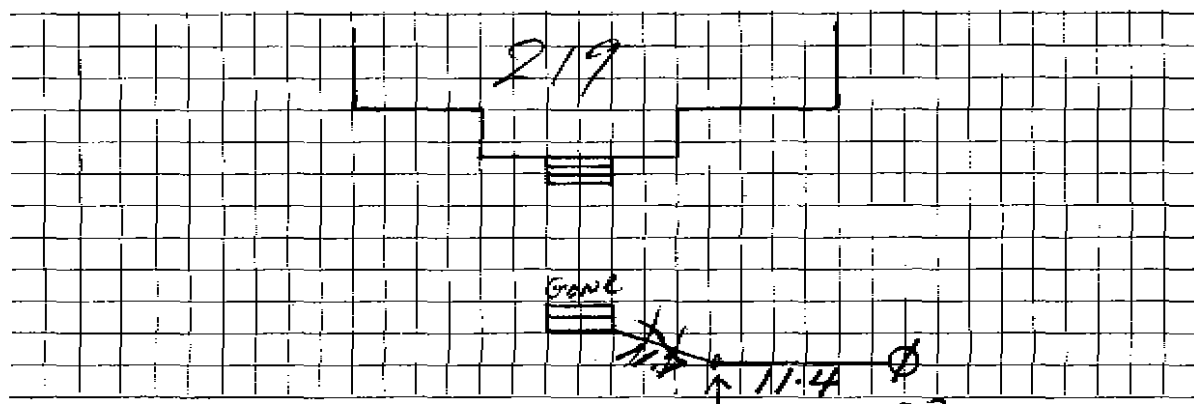

Connection made in \_\_\_\_\_ Street. 12' 10" work completed ECB 19

Remarks: