

Name W. H. Larson

1460

Service No. ~~87~~ 931

Address 9 Plymouth Road
221 Follen Road

Location 221 Follen Road

Kind of Pipe

Size

Size of Main

Repair—Renewal—New Service

Location

Date
1940

Material

Amount

Total

Date

Amount

Aug. 30,

2 hrs. @ 60¢

1 20

October 2, 1940 Paid

(35)

6 88

Com 9/30/40

10% Overhead

12

1 32

(37)

7 88

55' 3/4" Copper tubing @ 18¢

9 90

(43)

11 02

1 3/4" CxI S.& W.

2 25

1 hr. trucking

75

Trench repairs

11 56

\$ 25 78

25 78

Labor

DATE

TOWN OF LEXINGTON—BOARD OF PUBLIC WORKS WATER DIVISION

The undersigned applies for a supply of water at No. 221 St. and hereby agrees to comply with the rules and regulations as now, or at any future time, established by the Board of Selectmen.

Am't. of Estimate \$ 50.00


Owner _____

Am't. Paid \$ _____

Address _____

Builder _____

Sketch of Service Here

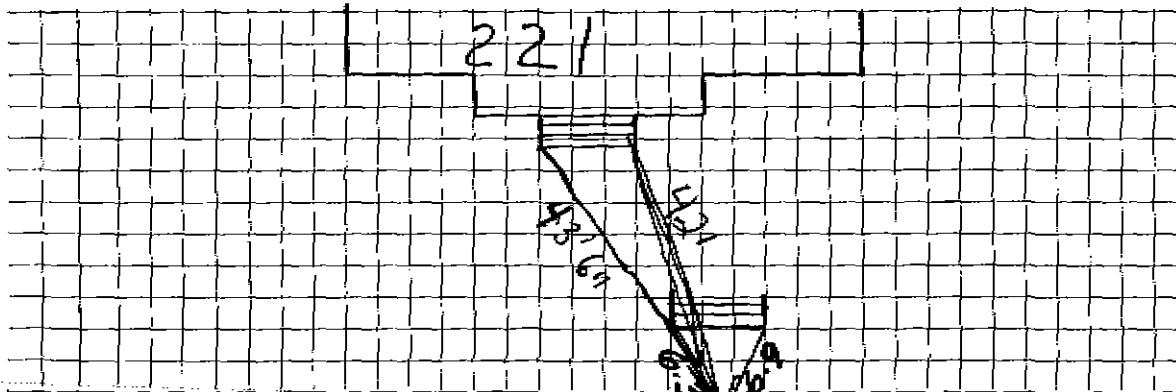

Connection made in _____

Street.

20.0 Work completed

19

Remarks:

0.5 mH