

Name W. H. Larson (Owner: Frank J. Moore)

Service No. ~~46~~ 932

Address 11 Plymouth Rd.
222 Follen Road

#3758

Location 222 Follen Road

Kind of Pipe Size Size of Main

Repair—Renewal—New Service

Location

Date	Material	Amount	Total	Date	Amount
1940					
Aug. 21,	2 hrs @ 60¢	1 20		August 21, 1940 Deposited	50 00
com 9/30/40	10% Overhead	12	1 32	October 2, 1940 Refunded	17 92
	85' 3/4" Copper tubing @	18¢	15 30		32 08
	1 3/4" C. x 1/2" I.S. & W.		2 25		
	1 3/4" C. Union (3 part)		90		
	1 hr. trucking @ 75¢		75		
	Trench repairs		11 56		
			32 08		
	Labor				

Hadley Press, Inc., Lexington

DATE Aug 21, 1948

TOWN OF LEXINGTON—BOARD OF PUBLIC WORKS
WATER DIVISION

The undersigned applies for a supply of water at No. 222 Follen Road St. and hereby agrees to comply with the rules and regulations as now, or at any future time, established by the Board of Selectmen.

Am't. of Estimate \$ _____

Owner Frank J. Moore


Am't. Paid \$ _____

Address 222 Follen Road

Builder J. H. Larson

Lexington, Mass.

Sketch of Service Here

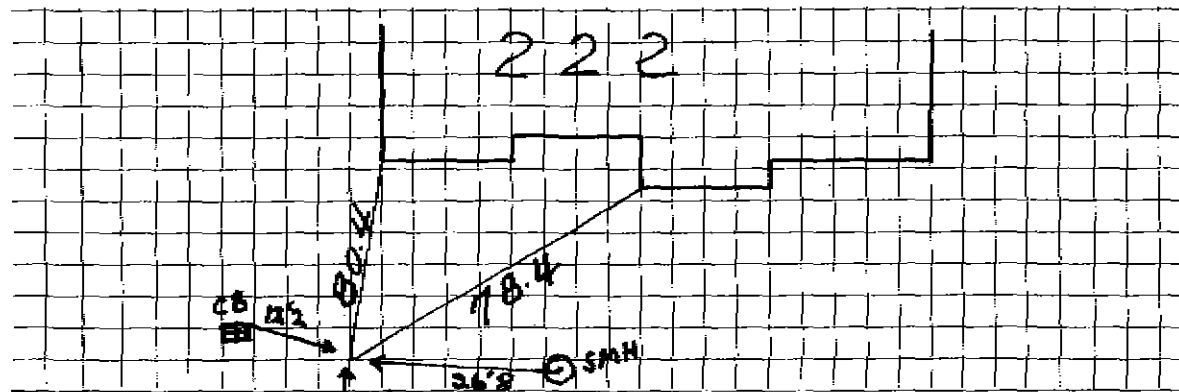

Connection made in _____ Street. Work completed _____ 19

Remarks: