

Name S. A. Morash (Builder)
 Address 16 Mystic Bank, Arlington, Mass.
 #225 Fallen Rd

Service No. ~~97~~ 933

#3786

Location 225 Follen Road

Kind of Pipe Size Size of Main
~~Repair~~ ~~Renewal~~ ~~New Service~~ Location

Date 1941	Material	Amount	Total	Date	Location	Amount
April 29	36 hrs. @ 60¢	21 60		April 21 1941	Deposited	65 00
<i>Sum 6/30/41</i>	10% Overhead	2 16	23 76	July 2, 1941	Refunded	5 40
	42' 1" Copper tubing @ 22¢		9 24			59 60
	1 1" C.Stop & Waste		2 50			
	1 1" C.Union (3 part)		1 10			
	Trucking - 4 hrs. @ 75¢		3 00			
	Trench repairs		20 00			
			59 60			
	Labor					

DATE July 10 1941

TOWN OF LEXINGTON—BOARD OF PUBLIC WORKS

WATER DIVISION

P4

The undersigned applies for a supply of water at No. 225 Follen St. and hereby agrees to comply with the rules and regulations as now, or at any future time, established by the Board of Selectmen.

Am't. of Estimate \$ 11.00


Owner Mrs. Roy. Q. Frost

Am't. Paid \$ _____

Address 84 Mass Ave

Builder A. Frost Arlington
(See p. 207)

Sketch of Service Here

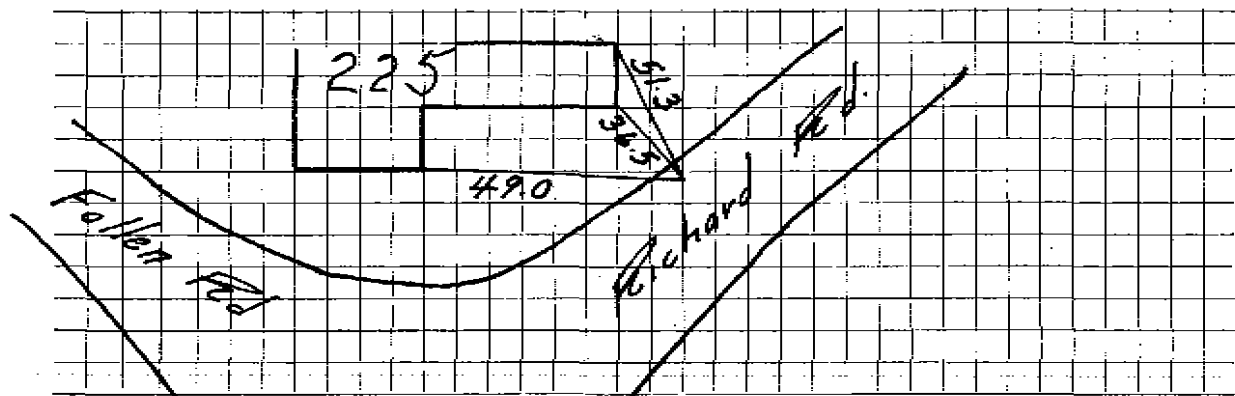

Connection made in _____ Street. Work completed _____ 19

Remarks: