

Name Alton W. Phelps

Service No. ~~934~~ 934

Address 42 Percy Road,
227 Follen Rd.

2504

Location 227 Follen Road

Kind of Pipe

Size

Size of Main

Repair—Renewal—New Service

Location

Date 1939	Material	Amount	Total	Date	Amount
12/30/39	2 hrs. @ 60¢	1 20		December 23, 1939	28 00
1-27-40	2 " @ 65¢	1 30	2 50	January 19, 1940	9 05
	10% Overhead		25		18 95
	40' 3/4" Copper tubing @ 19¢		7 60		
	1 3/4" Cx 1/2" I.S. & W.		2 10		
	2 hrs. trucking @ 75¢		1 50		
	Trench repairs		5 00		
			18 95		
	Labor				

Hadley Press, Inc., Lexington

DATE _____

TOWN OF LEXINGTON—BOARD OF PUBLIC WORKS WATER DIVISION

The undersigned applies for a supply of water at No. 227 FOLLEN ROAD and hereby agrees to comply with the rules and regulations as now, or at any future time, established by the Board of Selectmen.

Am't. of Estimate \$ _____

Owner ALTON M. PHELPS.


Am't. Paid \$ _____

Address 42 PERCY ROAD.

Builder STANLEY I. PHALEN.

LEXINGTON, MASS.

Sketch of Service Here

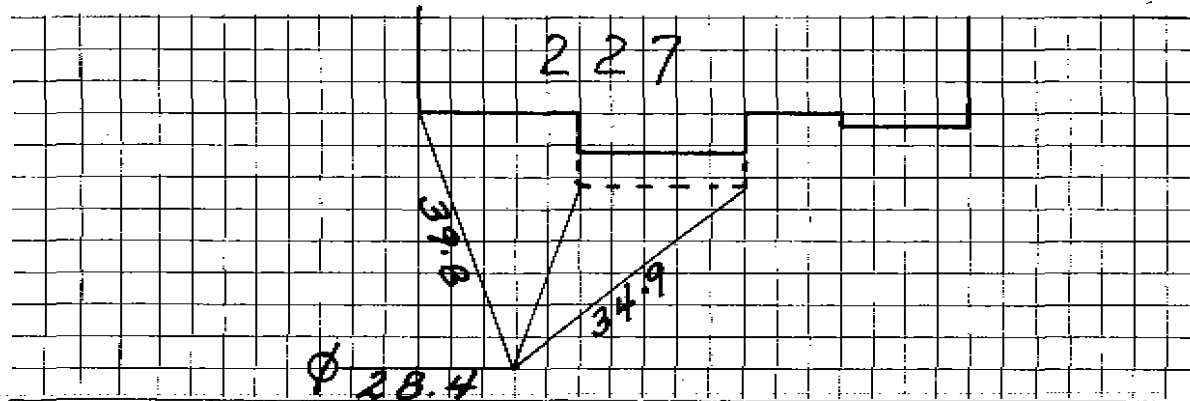

Connection made in _____ Street.

Work completed _____ 19

Remarks: