

WATER SERVICE RECORD

Name Robert Ericson

Service No. 280

Address 228 Follan Road

Location

~~REPAIR~~ New Service

Comm 5-4-59


Date	Material	Amount	Total	Date	Amount
3-26-59	Labor	3 70		12-11-58	Deposit
	10% O.H.	37	4 07	5-4-59	Return
	60' 3/4" Copper Tubing @.3666		22 00		
	1 3/4" C x 1/2" I.W.H. Stop & Waste		5 84		NON CHARGE
	1 Hr. Trucking @.75		75	3-26-59	Labor
			32 66		
				36'	3/4" Copper Tube @.3666
				1	3/4" C Corp Cock
				1	3/4" C Curb Cock
				1	Box & Rod
				1	1/2" Straight Tailpiece
				1	1/2" Offset Tailpiece
					33 57

Applied to S.M. 224

DATE _____

TOWN OF LEXINGTON — BOARD OF PUBLIC WORKS
WATER DIVISION

Sketch of Service Here

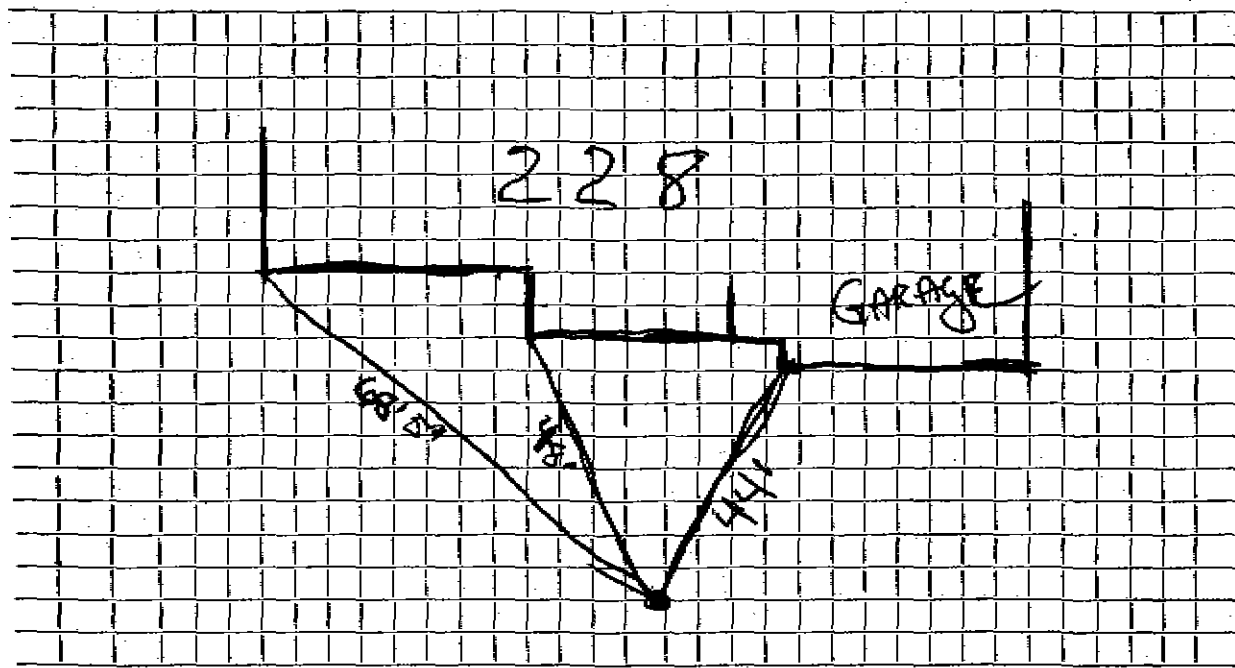

Connection made in Street. Work completed

Remarks:
.....
.....