

Name Builder: E. E. MacPhee

Service No. ~~88~~ 935

Address 37 Vaille Ave., Lexington
229 Follen Rd.

3357

Location 229 Follen Road for Robert Linnenty

Kind of Pipe

Size

Size of Main

Repair—Renewal—New Service

Location

Date	Material	Amount	Total	Date	Amount
Sept. 28, 1940	4 hrs. @ 60¢	2 40		September 26, 1940	20 00
Corr 12-31-40	10% Overhead	24	2 64	Dec 31, 1940	3 63
	42' 3/4" Copper tub. @ 19¢		7 98		16 37
	1 3/4" C.S. & W.		2 25		
	2 hrs. trucking @ 75¢		1 50		
	Trench repairs		2 00		
			16 37		
	Labor				

Hadley Press, Inc., Lexington

DATE _____

TOWN OF LEXINGTON—BOARD OF PUBLIC WORKS

WATER DIVISION

The undersigned applies for a supply of water at No. 229 Allen St. and hereby agrees to comply with the rules and regulations as now, or at any future time, established by the Board of Selectmen.

Am't. of Estimate \$ 20

Owner

Finnerty
Robert Finnerty

Am't. Paid \$ _____


Address

Kennett

Builder E. E. MacPha

37 Valley Ave
Dep.

Sketch of Service Here

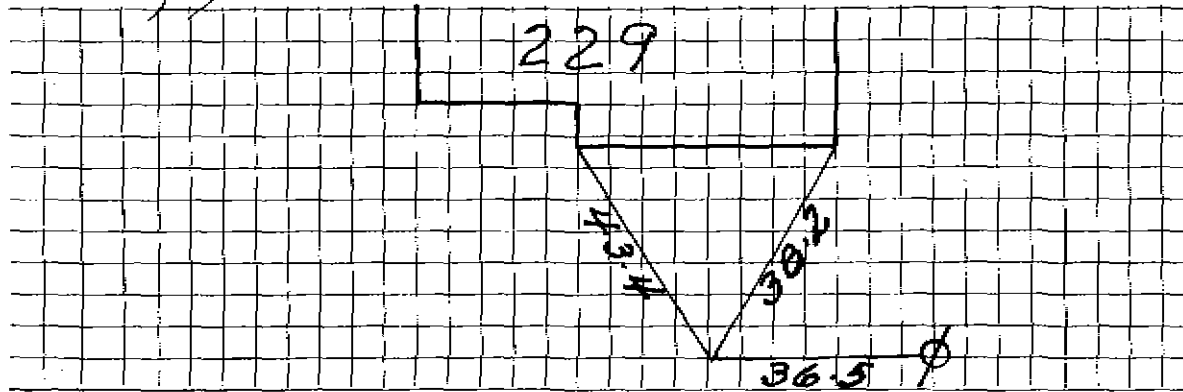

Connection made in _____

Street.

Work completed _____

19

Remarks: