

WATER SERVICE RECORD

Name A. J. Comeau

Service No. 216

Address 230 Follen Road

#5956

Location Lexington

#6989

~~Repair - Renewal~~ New Service

Com. 11-24-52


Date	Material	Amount	Total	Date	Amount
10/7/52	Labor	1 63		9-11-52 Deposited	25 -
	10% overhead	16	1 79	12-19-52 Paid	(1 94)
	60' - 3/4" copper tubing@ .34		20 40		<u>NON CHARGE</u>
	1 - 3/4" C x 3/8 I.W.H. stop & waste		4 00	10/7/52 Labor	1 63
	1 hr. trucking		75	32' - 3/4" Copper tubing@ .34	10 88
			26 94	1 - 3/4" C. corp-cock	4 33
				1 - 3/4" C x 3/4" C. curb-cock	4 67
				1 box and rod	3 90
				1 - 1/2 straight tail piece	50
				1 - 1/2 offset tail piece	50
				1 hr. trucking	75
					<u>27 16</u>

11-24-52

DATE _____

TOWN OF LEXINGTON — BOARD OF PUBLIC WORKS
WATER DIVISION

Sketch of Service Here

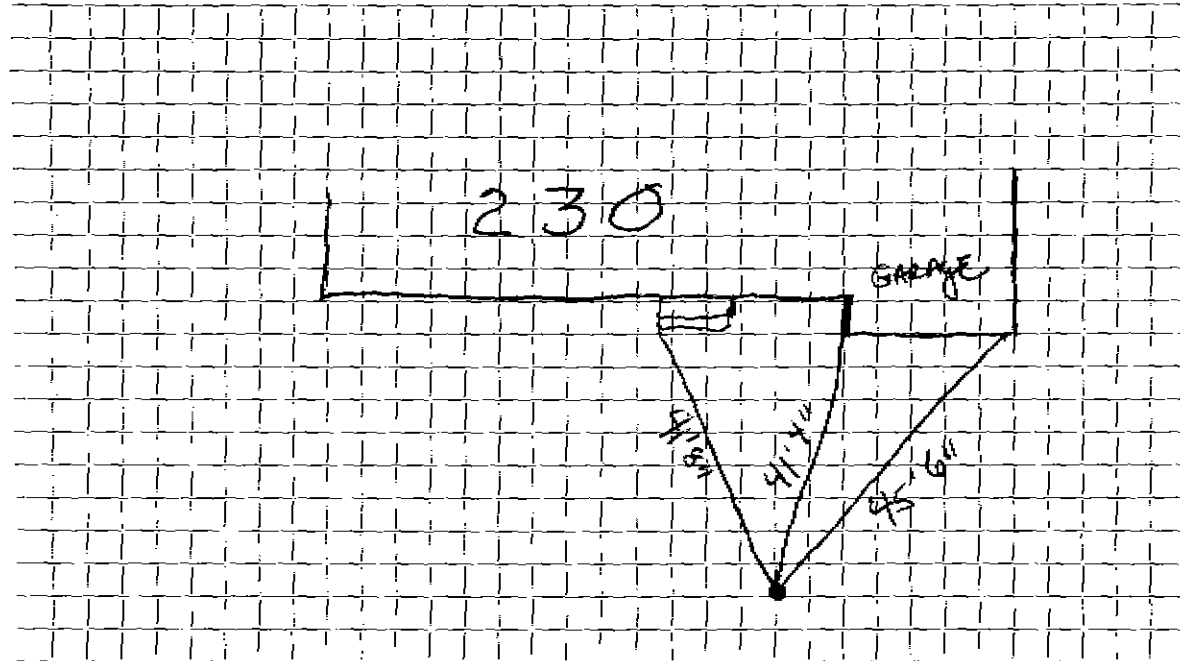

Connection made in Street..... Work completed

Remarks:
.....
.....