

WATER SERVICE RECORD

Name Angus McIver

Service No. 58

Address 30 Follen Road

Location

~~Repair~~—Renewal—New Service

Comm. 6-10-57


Date	Material	Amount	Total	Date	Amount
4/10/57	Labpr	20 77		4-8-57	Deposit \$ 50 00
	10% overhead	2 08	22 85	6-10-57	Refund 2 41
	45' 3/4" Copper tubing @.4228		19 03		# 47 59
	1 3/4" C x 1/2 I.W.H. Stop&Waste		4 96		<u>NON CHARGE</u>
	1 Hr. trucking @.75		75	4/11/57	Labor 17 52
			47 59		37' 3/4" Copper tubing @.4228 15 64
					1 3/4" C Corp Cock 4 64
					1 3/4" C Curb Cock 5 94
					1 Box & Rod 4 62
					1/2 Hr. Town Shovel @6.50 3 25
					1 Hr. trucking @.75 75
					<u>52 36</u>

DATE _____

TOWN OF LEXINGTON — BOARD OF PUBLIC WORKS

WATER DIVISION

Sketch of Service Here

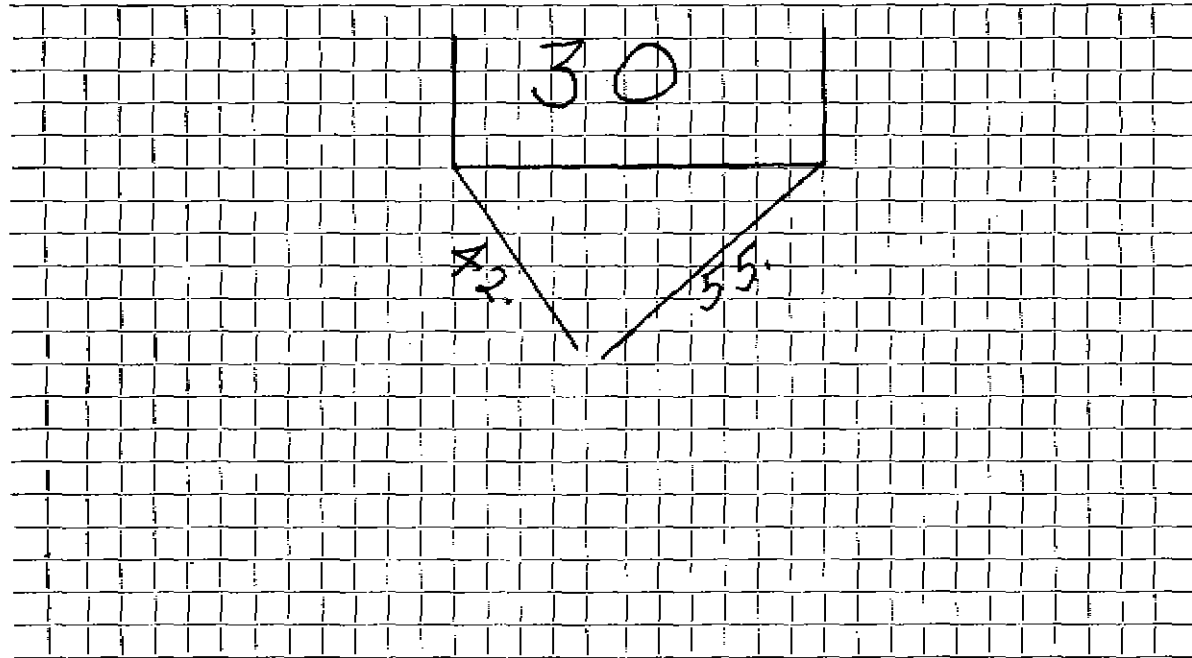

Connection made in Street. Work completed

Remarks:

.....
.....