

WATER SERVICE RECORD

Name

Service No.

Address 37 Follen Road

Location


Repair—~~Renewal~~ ~~New Service~~ W.O. #3061.

Date	Material	Amount	Total	Date	Amount
8/4/31	38' 1" CLP.				
					outside(non-charge)
				2-2-75	Labor \$20.97
				2-3-75	" \$219.12
				3-27-75	" 32.78
				5'	3/4" Copper Pipe
				1	1" Repair Clamp
				1	1" x 4" Nipple
				1	1" Coupling
				1	3/4" Union
				1	Box and Rod
				1	3/4" Curb Cock
				5	Tons Gravel
				1/2	Ton Cold Patch
				1	Patch 12' x 6'
				1	" 12' x 3'

DATE _____

TOWN OF LEXINGTON — BOARD OF PUBLIC WORKS
WATER DIVISION

Sketch of Service Here

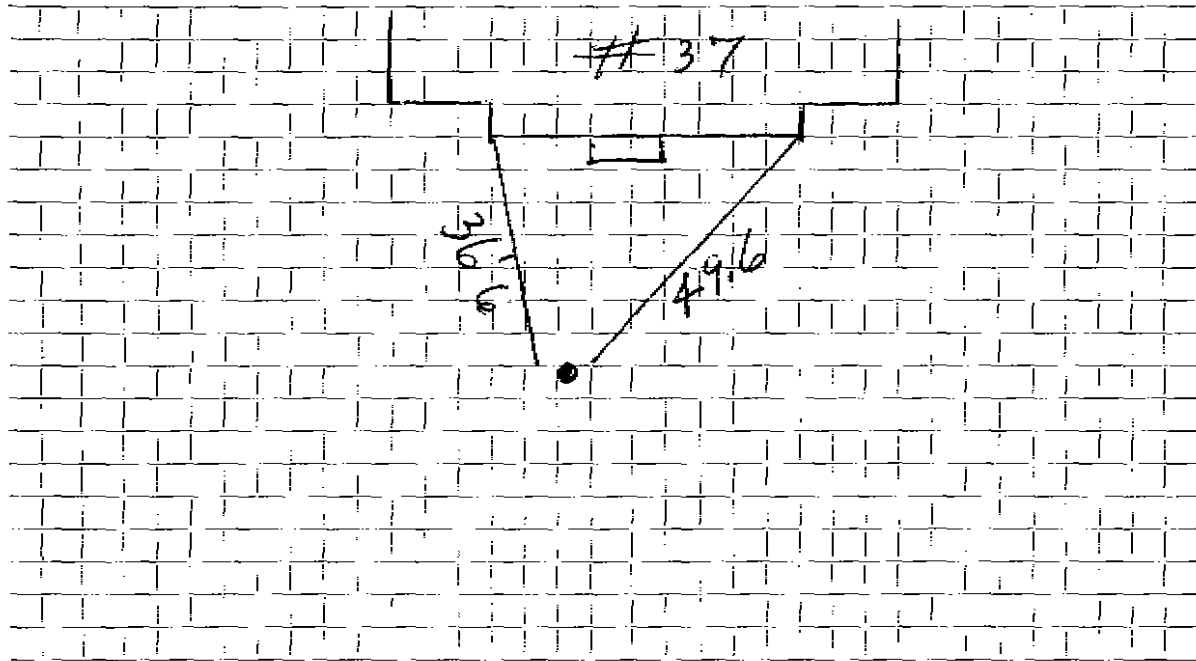

Connection made in Street. Work completed

Remarks:

.....

.....