

## WATER SERVICE RECORD

Name C. Ruth Stone Snow

Service No. 4

Address 43 Follen Road

Location

~~Repair - Renewal - New Service~~

Comm. 2-25-57


Date	Material	Amount	Total	Date	Amount	
1/25/57	Labor	47 38		1-24-57	Deposit	\$ 150 00
	10% overhead	4 74	52 12	2/25/57	Refund	55 09
	40' - 3/4" Copper tubing @ .4396	17 58				\$ 94 91
	1 - 3/4"x $\frac{1}{2}$ " I.W.H. Stop & Waste	4 96				
	1 hr. trucking		75			
	3 hrs. Town Shovel @ 6.50		19 50			
			94 91			

DATE \_\_\_\_\_

TOWN OF LEXINGTON — BOARD OF PUBLIC WORKS

**WATER DIVISION**

Sketch of Service Here

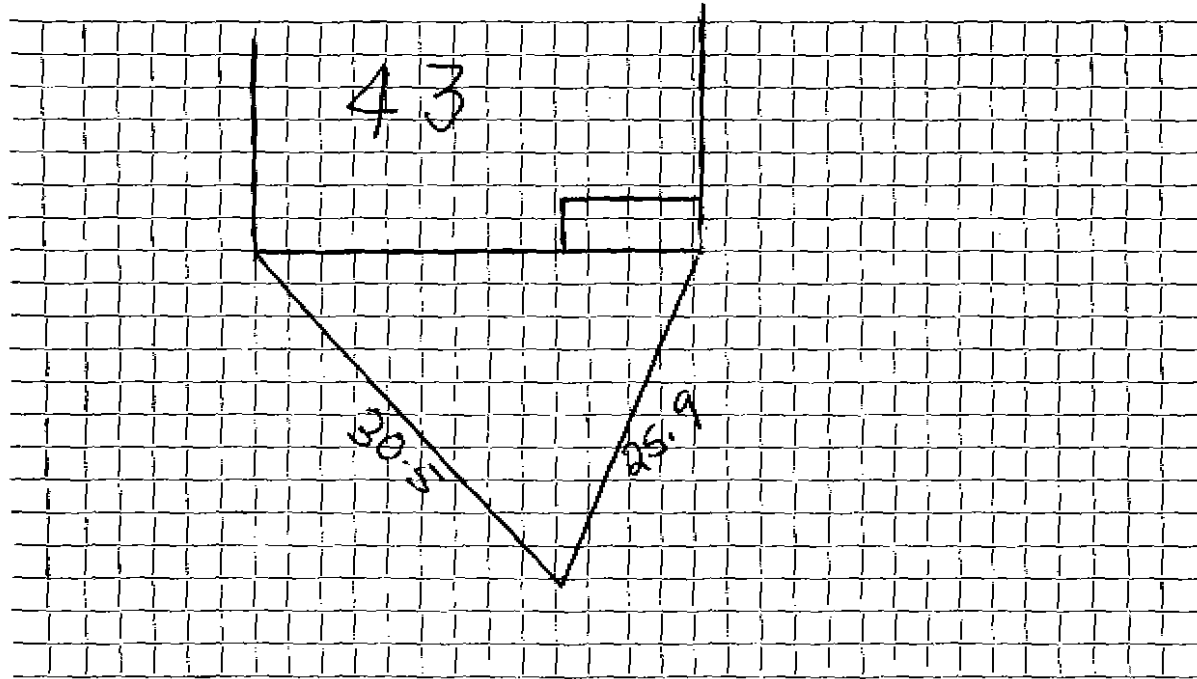

Connection made in ..... Street. Work completed .....

Remarks: .....  
.....  
.....