

WATER SERVICE RECORD

1344

Name Dianne Estates

Service No. 145

Address 51 Follen Road

Location

Repair ~~Renewal~~ New Service


Comm 12-1-58

Date	Material	Amount	Total	Date		Amount
7/25/58	labor	15 04		7-22-58	Deposit	100 00
	10% overhead	1 50		12-1-58	Retund	31 30
			16 54			68 68
	40' 3/4" copper tubing @ .37	14 80			NON CHARGE	
	1 3/4" Cx 1/2 IWH stop & waste	5 84			labor	6 77
	1 hr. trucking @ .75		75		18' 3/4" copper tubing @ .37	6 66
	1 1/2 hr. town shovel @ 6.50		9 75		1 3/4" C corp cock	4 64
	1 hr. trucking @ 3.00		3 00		1 3/4" C curb cock	6 03
	1 hr. Roger trailer @ 3.00		3 00		1 box & rod	5 00
	15 x 3 patch		15 00		1 1/2 straight tail piece	50
			68 68		1 1/2 offset tail piece	50
					1/2 hr. town shovel @ 6.50	3 25
						33 35

TOWN OF LEXINGTON — BOARD OF PUBLIC WORKS

WATER DIVISION

Sketch of Service Here

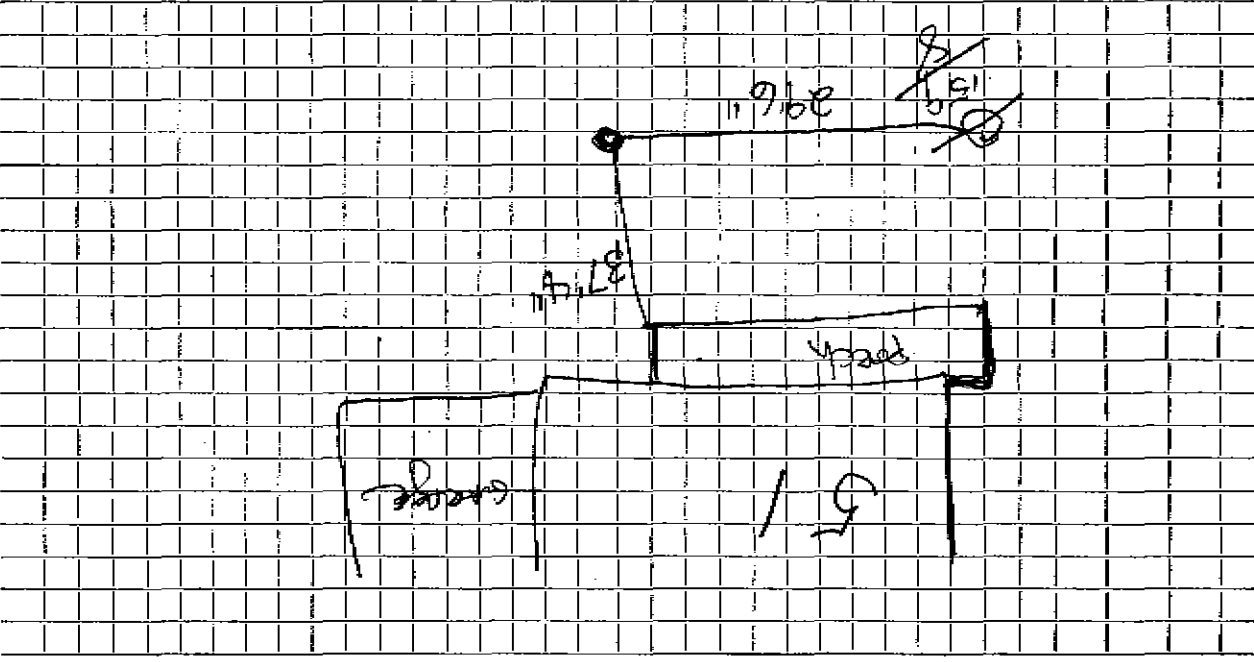

Connection made in

Street.

Work completed

Remarks:

DATE