

WATER SERVICE RECORD

Water Misc.
Service No.

Name

Address 52 Follen Road

Location

~~Repair~~ Renewal ~~New Service~~

COM 10/2/61


Date	Material	Amount	Total	Date	Amount
8-7-61	Labor	2.00			
	10% O.H.	.20	2.20		
	8' 1" Copper tubing @.56		4.48		
			6.68		
					NON CHARGE
10/18/61	81' 1" COPPER			8-7-61	Labor 83.54
	1 CC. Union				21' 1" Copper tubing @.56 11.76
					1 1" Adapter 3.29
10/11/61	15' 1" COPPER	14.85			1 1" Curb Cock 8.06
	1 1" 3 PART Union	4.89			1 Box & Rod 4.90
					1 1 1/4" x 6" C.L. Nipple .84
					1 1 1/4" Style 38 Clamp 2.25
					1 1 1/4" L.L. Coupling .77
					20 x 3 Patch 20.00
					3 hrs. Pippin Shovel @5.00 15.00
					2 hrs. Trucking @3.00 6.00
					156.41

TOWN OF LEXINGTON — BOARD OF PUBLIC WORKS

WATER DIVISION

DATE _____

Sketch of Service Here

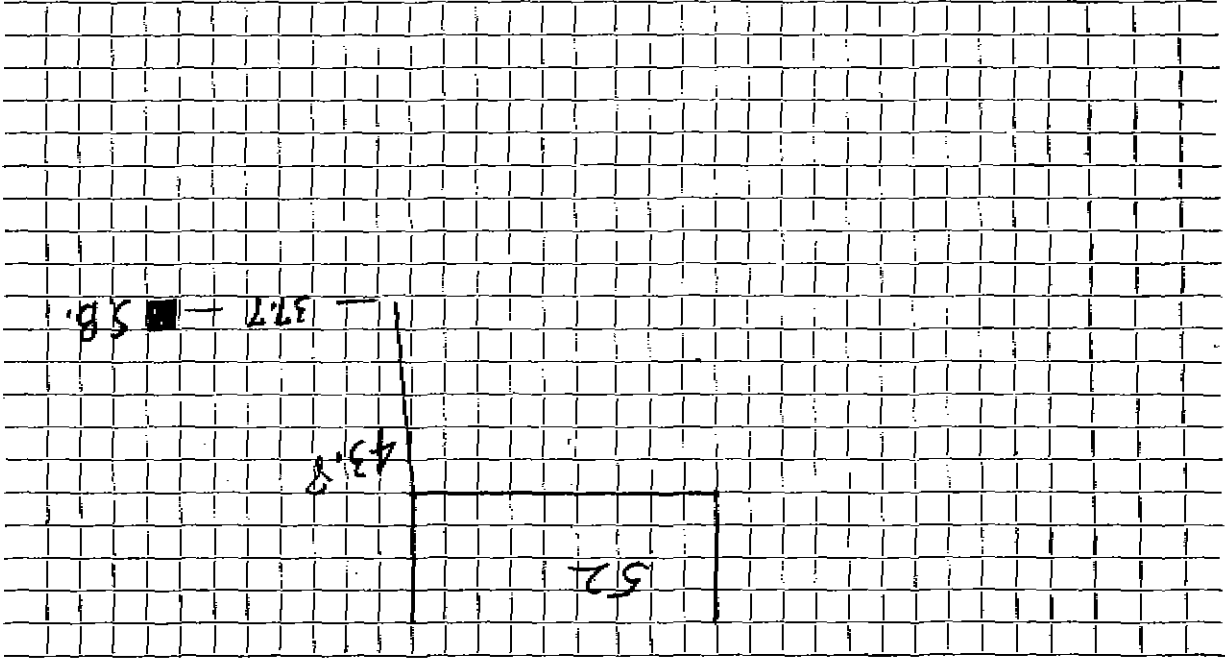

Connection made in _____

Street _____

Work completed _____

Remarks: _____

