

WATER SERVICE RECORD

#4250

Name Bernard Maloney

Service No.

271

Address 65 Follen Road

Location

~~Repair~~ ~~General~~ New Service

Comm 12-31-60

Date	Material	Amount	Total	Date	Amount
11-23-60	Labor	28.36		11-15-60	100.00
	10% O.H.	2.84	31.20	1-16-61	13.98
60'	3/4" Copper tubing @.42		25.20		113.98
1	3/4" G x 1/2 I.W.H. Stop & Waste		6.17		
1	3/4" G 3 part union		2.71	11-23-60	
2	hrs. Town Shovel @6.50		13.00	Labor	22.47
15 x 6	Patch		30.00	51'	3/4" Copper tubing @.42
2	hrs. Trucking @.3.00		6.00	1	3/4" G Corp Cock
			113.98	1	3/4" G Curb Cock
				1	Box & Rod
				1	1/2 Straight tailpiece
				1	1/2 Offset tailpiece
					60.98


Deposit
Paid

NON CHARGE

DATE _____

TOWN OF LEXINGTON — BOARD OF PUBLIC WORKS
WATER DIVISION

Sketch of Service Here

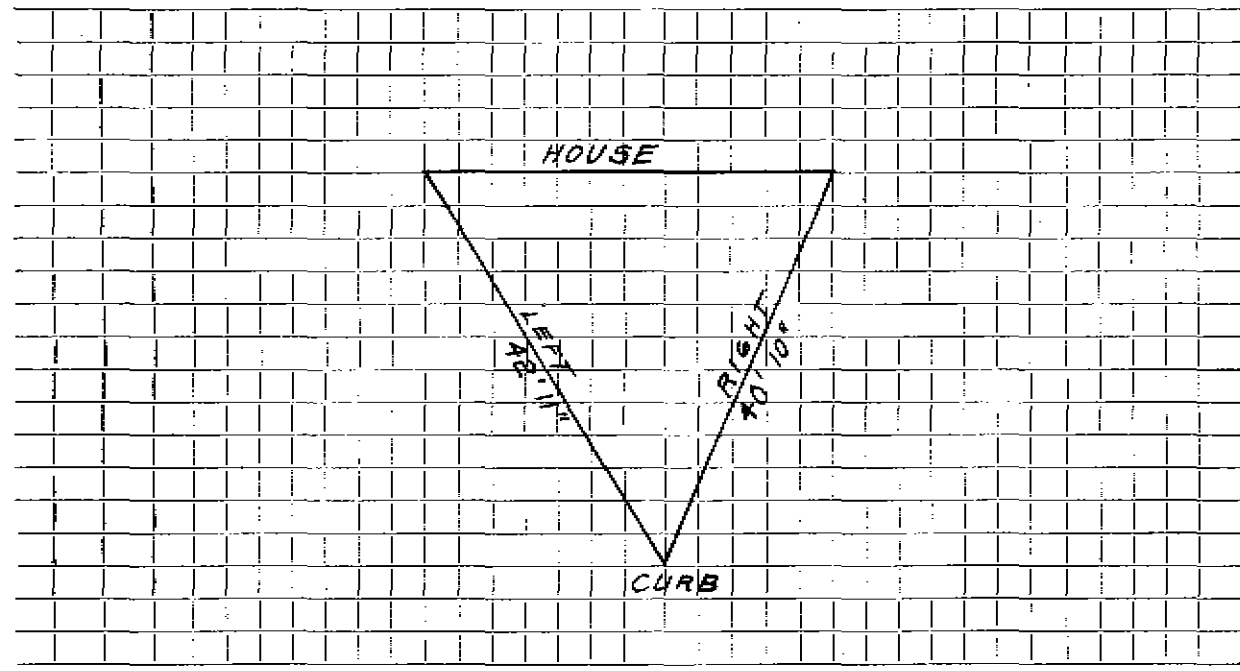

Connection made in Street. Work completed

Remarks:
.....
.....