



DATE \_\_\_\_\_

# TOWN OF LEXINGTON—BOARD OF PUBLIC WORKS

## WATER DIVISION

The undersigned **applies** for a supply of water at No. \_\_\_\_\_ St. and hereby agrees to comply with the **rules** and regulations as now, or at any future time, established by the Board of Selectmen.


Am't. of Estimate \$ \_\_\_\_\_

Owner LeMay

Am't. Paid \$ \_\_\_\_\_

Address 99 Follen Rd

Builder \_\_\_\_\_

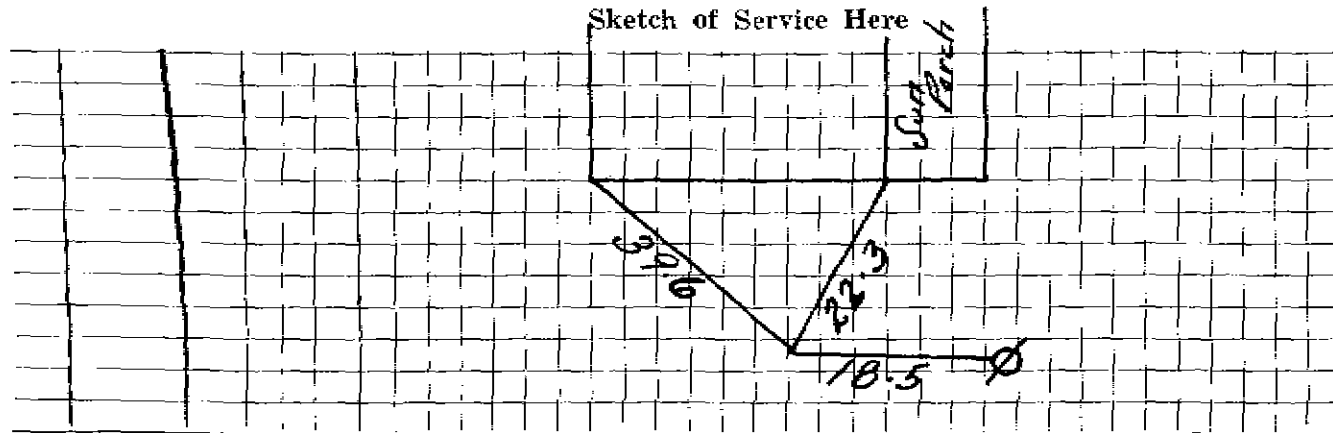

Connection made **in** \_\_\_\_\_ Street.

Work completed \_\_\_\_\_ 19


Remarks:



DATE July 1 2002

TOWN OF LEXINGTON — BOARD OF PUBLIC WORKS  
WATER DIVISION

Sketch of Service Here

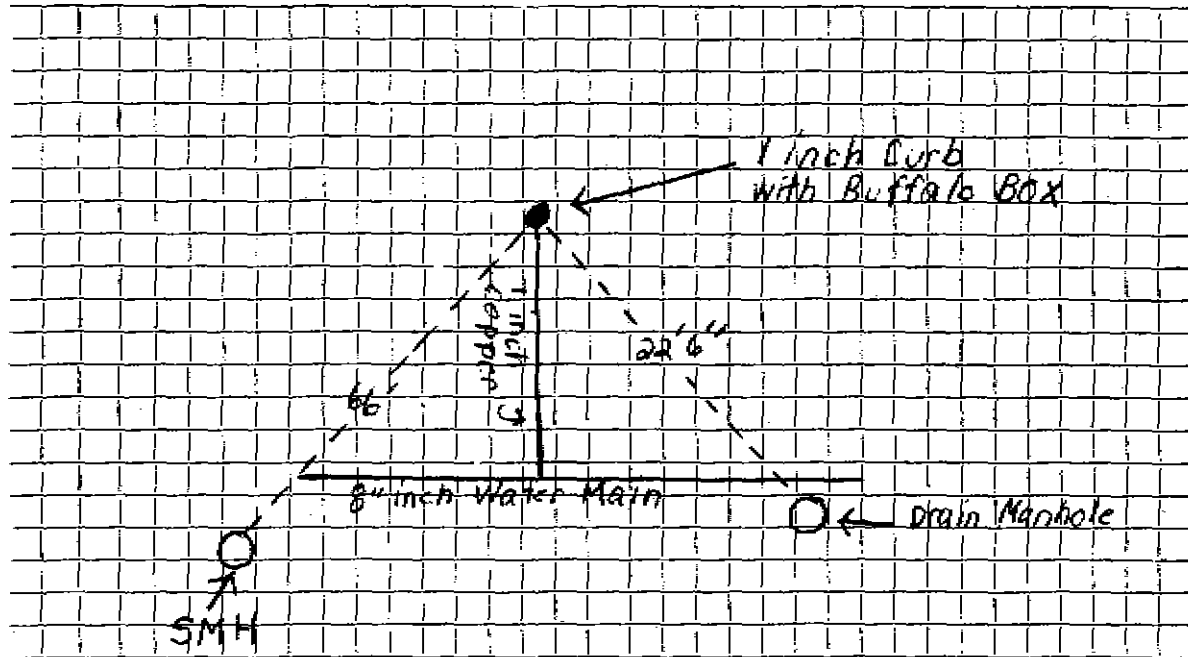

Connection made in ..... Street. Work completed .....

Remarks: Repair made in Water Main with a wraparound with a 1" Service Saddle

Name

Service No. 904

Address 99 Fallen Rd. # 3398

Location 99 Fallen Rd

Kind of Pipe

Size

Size of Main

Repair—Renewal—New Service

Location

Date

Material

Amount

Total

Date

Amount

Labor

DATE \_\_\_\_\_

# TOWN OF LEXINGTON—BOARD OF PUBLIC WORKS

## WATER DIVISION

The undersigned applies for a supply of water at No. \_\_\_\_\_ St. and hereby agrees to comply with the rules and regulations as now, or at any future time, established by the Board of Selectmen.

Am't. of Estimate \$ \_\_\_\_\_

Owner \_\_\_\_\_

*LeMay*


Am't. Paid \$ \_\_\_\_\_

Address \_\_\_\_\_

*99 Follen Rd*

Builder \_\_\_\_\_

Sketch of Service Here

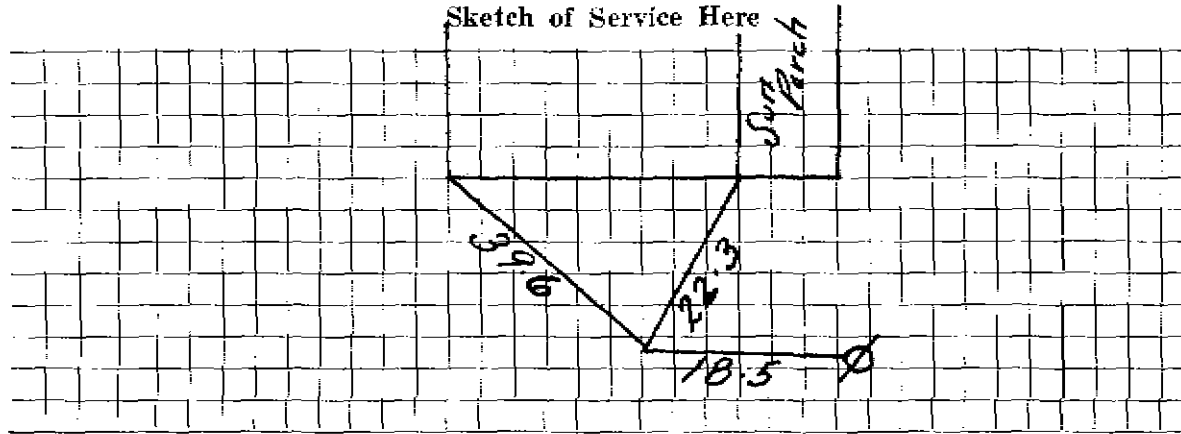

Connection made in \_\_\_\_\_ Street.

Work completed \_\_\_\_\_ 19

Remarks: