


TOWN OF LEXINGTON — BOARD OF PUBLIC WORKS

WATER DIVISION

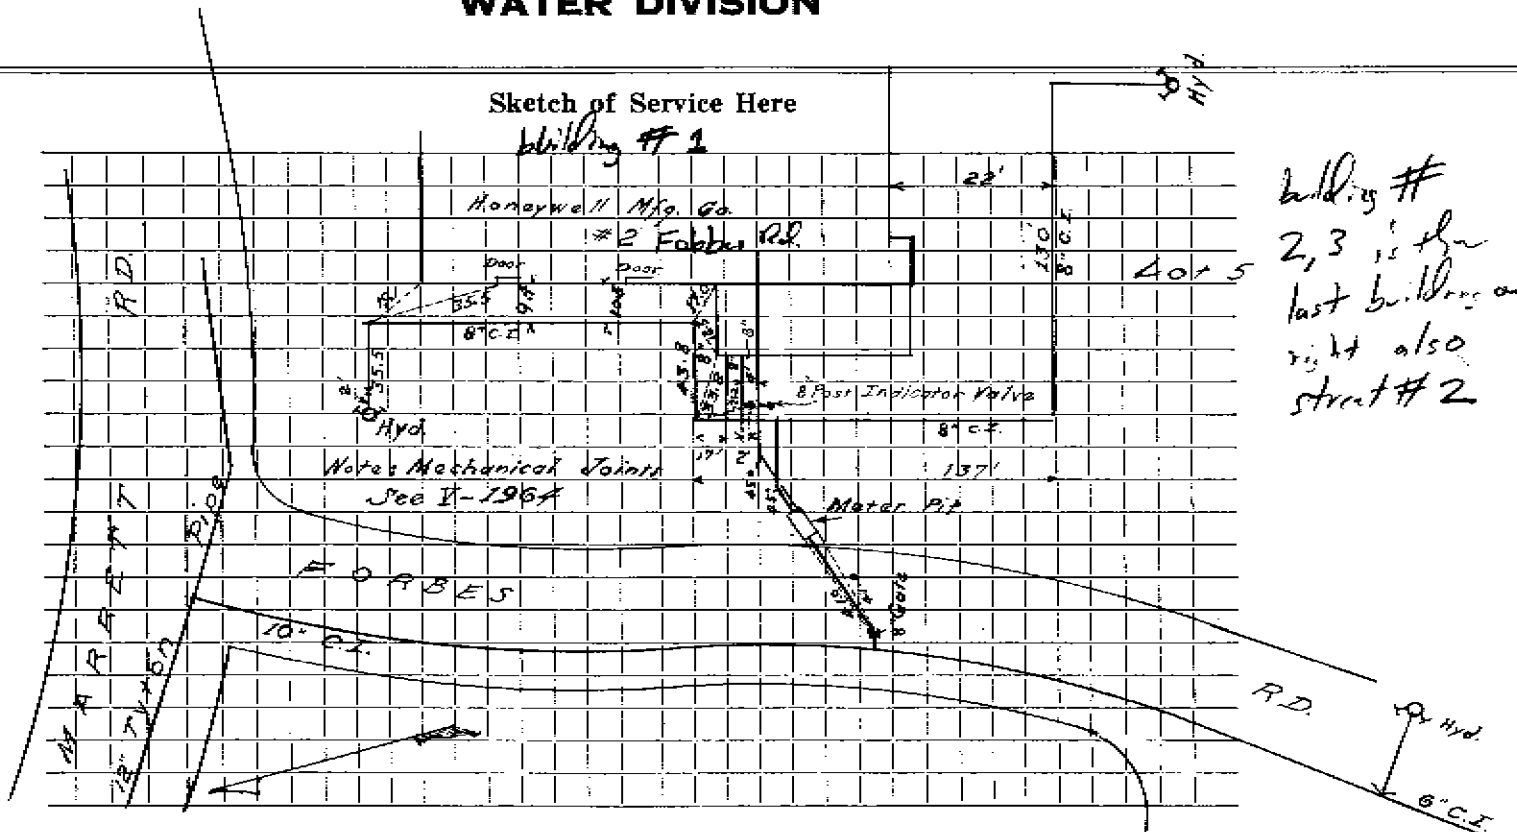

building #
2, 3 is the
last building on
right also
street # 2

Connection made in Street. Work completed

Remarks:

.....

.....