

Mrs. F. Ellis

Deposit paid by
W. G. Black

1225

Service No. ~~50~~ 938

Address 2 Forest Street

Location

Kind of Pipe

Size

Size of Main

Repair—Renewal—New Service

Location

Date
1941

Material

Amount

Total

Date

Amount

June 20

4 hrs. @ 60¢

2 40

June 7, 1941

Deposited

20.00

10% Overhead

24

2 64

September 6, 1941

Refunded

4.38

42' 3/4" Copper tubing @ 19¢

7 98

1 3/4" Cx 1/2" I.S. & W.

2 50

1 3/4" C. Union (3 part)

1 00

2 hrs. tracking @ 75¢

1 50

15 62

15 62

Labor

DATE 6/7 71

TOWN OF LEXINGTON - BOARD OF PUBLIC WORKS

WATER DIVISION

The undersigned applies for a supply of water at No. #2 Forest St. and hereby agrees to comply with the rules and regulations as now, or at any future time, established by the Board of Selectmen.

Am't. of Estimate \$ _____

Owner Theresa F. Eltis


Am't. Paid \$ 20.00

Address #2 Forest St

Builder W. G. Black

Lexington

Sketch of Service Here

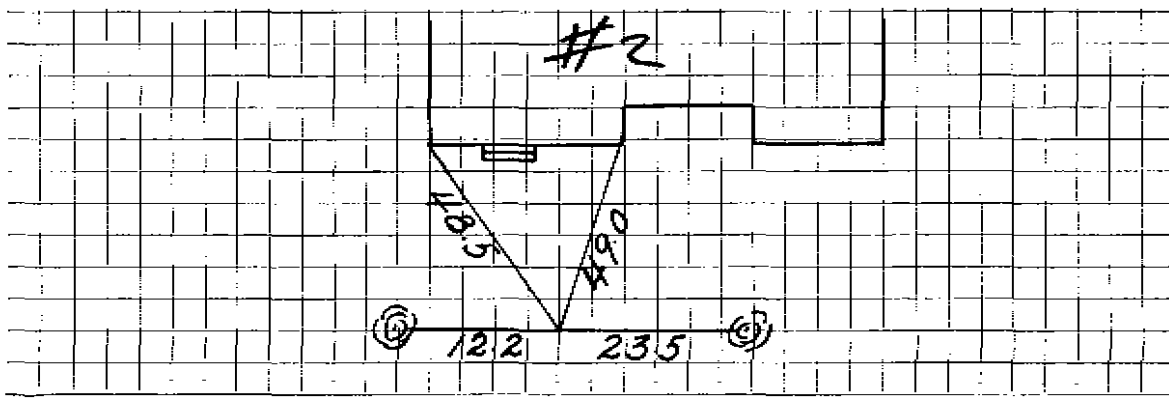

Connection made in _____ Street. Work completed _____ 19

Remarks: