

Name George Proctor

Service No. 937

Address 8 Forest Court

Lexington 73, Miss.

Location 8 Forest Court

Kind of Pipe

Size

Size of Main

Repair—Renewal—New Service

Non-Charge

Main to Curb

Location

Date	Material	Amount	Total	Date	Amount
April 16, '48	Labor	18 90			
	"	5 81	24 81		
	5' 1" Copper Tubing		1 17		
	1-1" C x 1" I Curb-cock		3 52		
	1 - 1 1/2" x 1" Red. Coupling		33		
	1 - 1" C. Adapter		1 70		
	1 - 1" Close Nipple		37		
	Trucking 1 hr. @ .75		75		
			<hr/>		
			32 71		
	<b>Labor</b>				

Hadley Press, Inc., Lexington

## TOWN OF LEXINGTON—BOARD OF PUBLIC WORKS

### WATER DIVISION

The undersigned applies for a supply of water at No. \_\_\_\_\_ St. and hereby agrees to comply with the rules and regulations as now, or at any future time, established by the Board of Selectmen.

Am't. of Estimate \$ \_\_\_\_\_


Owner \_\_\_\_\_

Am't. Paid \$ \_\_\_\_\_

Address \_\_\_\_\_

Builder \_\_\_\_\_

Sketch of Service Here

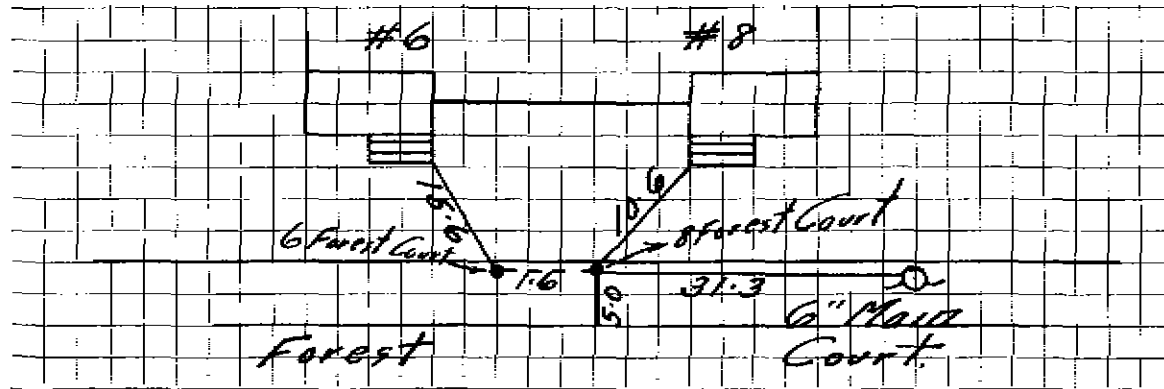

Connection made in \_\_\_\_\_ Street.

Work completed \_\_\_\_\_ 19

Remarks: