

Name John A. Longland  
 Address 22 Centre St., Cambridge, Mass.

987  
 Service No. 2 - 1944

Location 8 Forest Court

Kind of Pipe Size Size of Main

~~Repair—Renewal—Nozzles~~

Location

Date  
 1944

Material

Amount

Total

Date

Amount

Jan. 17, '44  
 Com No. 4

Labor	13 35		
10% Overhead	1 34	14 69	
17' 1 1/2" C.L. Pipe @ 33¢		5 61	
2 1 1/2" Reducing Couplings L.L. @ .39		78	
1 1 1/4" Br. Close Nipple		38	
2 1" " " " @ .37		74	
1 1" L. L. Elbow		30	
1 1" C.L. Nipple 6" long		40	
1 1" x 1" I.W.H. Stop & Waste		2 65	
1 1" Repair Clamp		78	
2 hrs. trucking @ 75¢		1 50	
2 hrs. compressor @ 2.25		4 50	
Labor		32 33	

Jan 18, 1944  
 June 27, 1944

Deposited  
 Paid

25 00  
 7 35  
 82 33

DATE \_\_\_\_\_

# TOWN OF LEXINGTON—BOARD OF PUBLIC WORKS

## WATER DIVISION

The undersigned applies for a supply of water at No. \_\_\_\_\_ St. and hereby agrees to comply with the rules and regulations as now, or at any future time, established by the Board of Selectmen.

Am't. of Estimate \$ \_\_\_\_\_


Owner \_\_\_\_\_

Am't. Paid \$ \_\_\_\_\_

Address \_\_\_\_\_

Builder \_\_\_\_\_

Sketch of Service Here

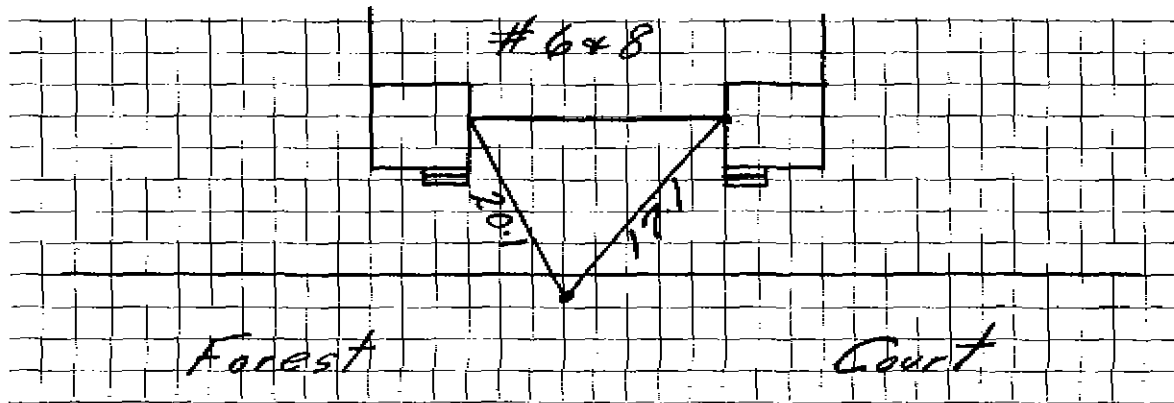

Connection made in \_\_\_\_\_ Street.

Work completed \_\_\_\_\_ 19

Remarks: