


DATE MAY 25, 1984

TOWN OF LEXINGTON — BOARD OF PUBLIC WORKS

WATER DIVISION

Sketch of Service Here

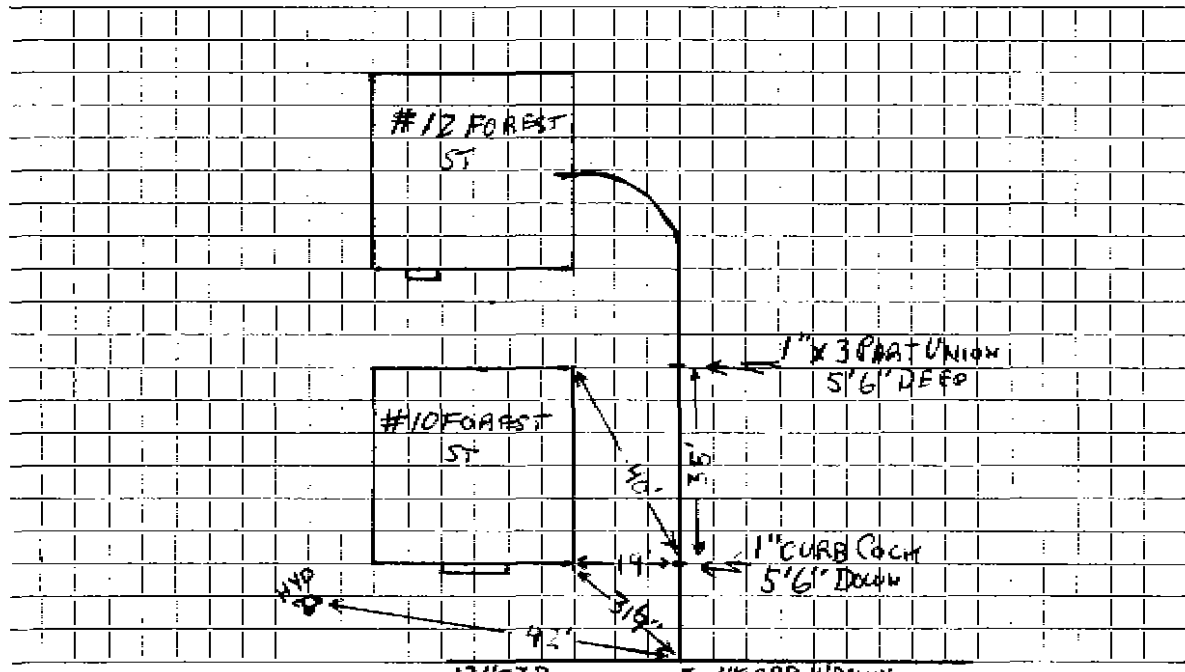

Connection made in FOREST ST 12' CIP Street. Work completed MAY 25, 1984

Remarks:

.....

.....