


DATE _____

TOWN OF LEXINGTON — BOARD OF PUBLIC WORKS
WATER DIVISION

Sketch of Service Here

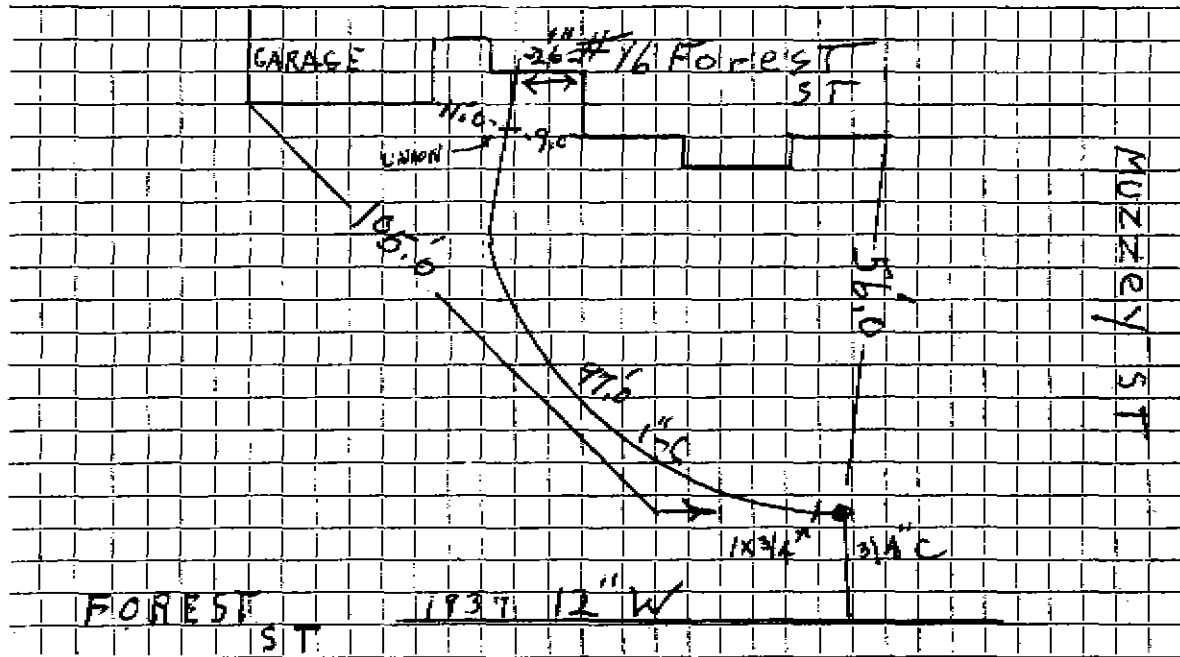

Connection made in Street. Work completed 2004 J. McLaughlin...
Remarks: Service changed to 12" w-1937
way Church.