

Name John Baskin

Service No. ~~88~~ 948  
# 6051

Address 45 Adams Street, Lexington

Location 20 Forest Street

#18 - #20 Forest Street

Kind of Pipe

Size

Size of Main

~~Repair—Renewal—New Service~~

Location

Date  
1943

Material

Amount

Total

Date

Amount

Oct..1,

Labor

10 80

Dec. 1943

cessities

20 00

10% Overhead

1 08

11 88

Nov 4. 1943

Refund

4 83

13' 1" C.L. Pipe @ 26'

3 68

1 1" L. L. Coupling

21

1 1"x3/4" L.L. Elbow

30

1 3/4" Space nipple

25

1 3/4" x 1/2" I. C. R. Stop & waste

2 35

Tracking- 2 hrs. @ 75¢

1 50

20 17

30 17

Non-chargeable:

2 1/2" str. tail pcs. @ 38¢

76

1 3/4" Copper x 1" I. Curb cock

2 75

1 3/4" " corp. cock

2 25

6' Labo 3/4" " tubing @ 21¢

1 26

1 box & rod

1 65

8 67

Lanley Press, Inc., Lexington

DATE \_\_\_\_\_

# TOWN OF LEXINGTON—BOARD OF PUBLIC WORKS

## WATER DIVISION

The undersigned applies for a supply of water at No. 20 Forest St St. and hereby agrees to comply with the rules and regulations as now, or at any future time, established by the Board of Selectmen.

Am't. of Estimate \$ 75<sup>00</sup>


Owner John Buskin

Am't. Paid \$ \_\_\_\_\_

Address 45 Adams St  
Lex

Builder \_\_\_\_\_

Sketch of Service Here

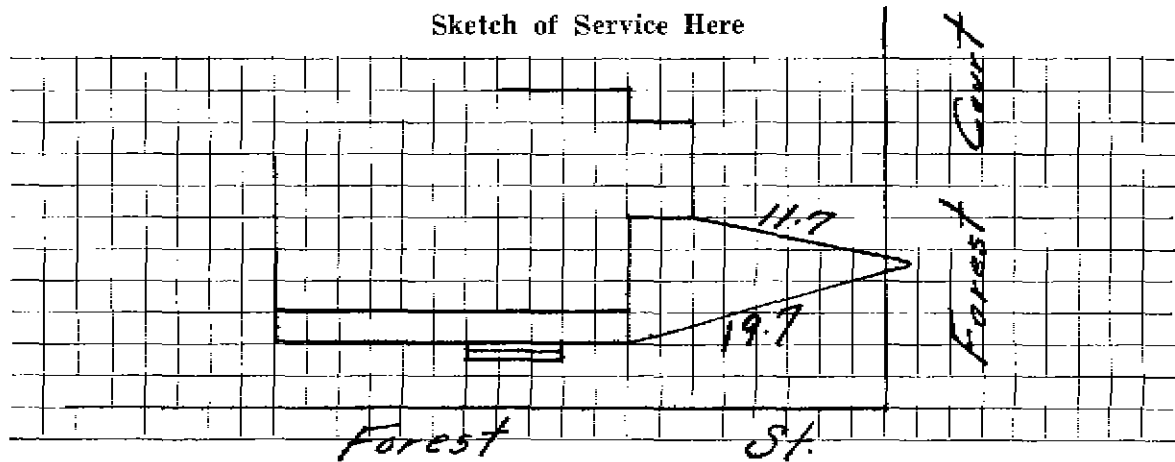

Connection made in \_\_\_\_\_ Street. Work completed \_\_\_\_\_ 19

Remarks: