


DATE _____

TOWN OF LEXINGTON — BOARD OF PUBLIC WORKS

WATER DIVISION

Sketch of Service Here
#19 FOREST ST.

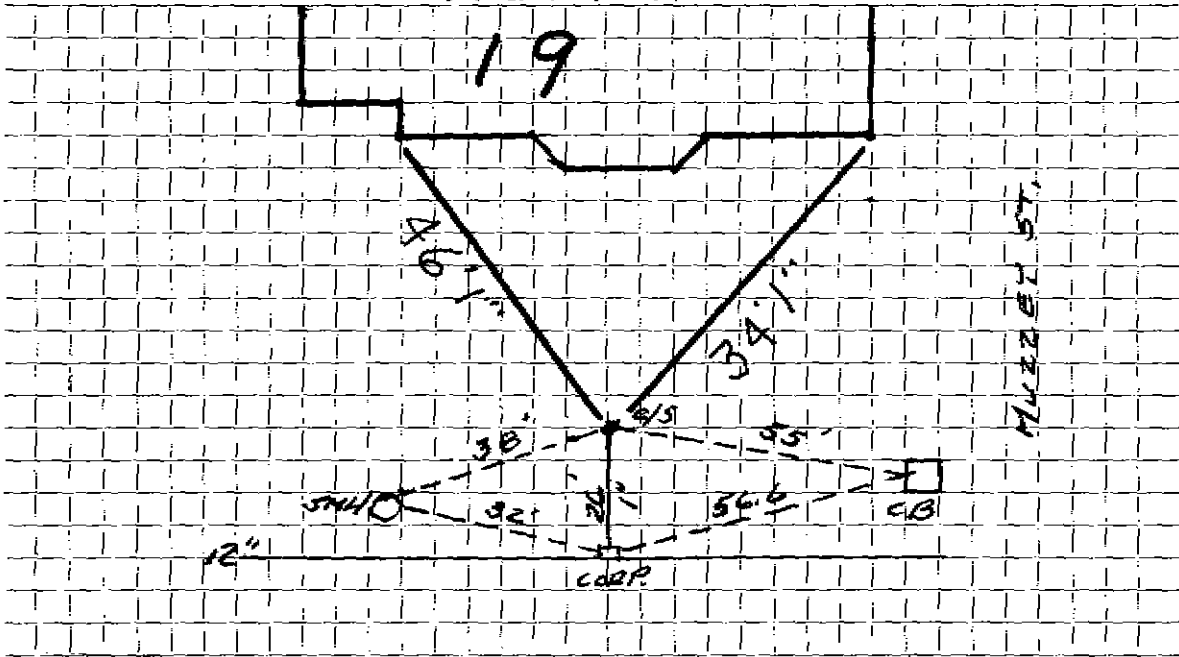

Connection made in FOREST ST. Street. Work completed

Remarks:

.....

.....