

Meresa F. Ellis (Deposit paid by
W. G. Black

1225

Service No. ~~50~~ 938

Address 2 Forest Street

Location

Kind of Pipe

Size

Size of Main

Repair—Renewal—New Service

Location

Date 1941	Material	Amount	Total	Date	Location	Amount
June 20 <i>Sum 9/14/41</i>	4 hrs. @ 60¢	2 40		June 7, 1941	Deposited	20 00
	10% Overhead	24	2 64	September 4, 1941	Refunded	4 38
	42' 3/4" Copper tubing @ 19¢		7 98			
	1 3/4" Cx 1/2" I.S. & W.		2 50			
	1 3/4" C. Union (3 part)		1 00			
	2 hrs. trucking @ 75¢		1 50			
			15 62			15 62
	Labor					

Hadley Press, Inc., Lexington

DATE 6/7 11

TOWN OF LEXINGTON - BOARD OF PUBLIC WORKS
WATER DIVISION

The undersigned applies for a supply of water at No. #2 Forest St. and hereby agrees to comply with the rules and regulations as now, or at any future time, established by the Board of Selectmen.

Am't. of Estimate \$ _____

Owner Theresa F. Eltis


Am't. Paid \$ 20.00

Address #2 Forest St

Builder H. G. Black

Lexington

Sketch of Service Here

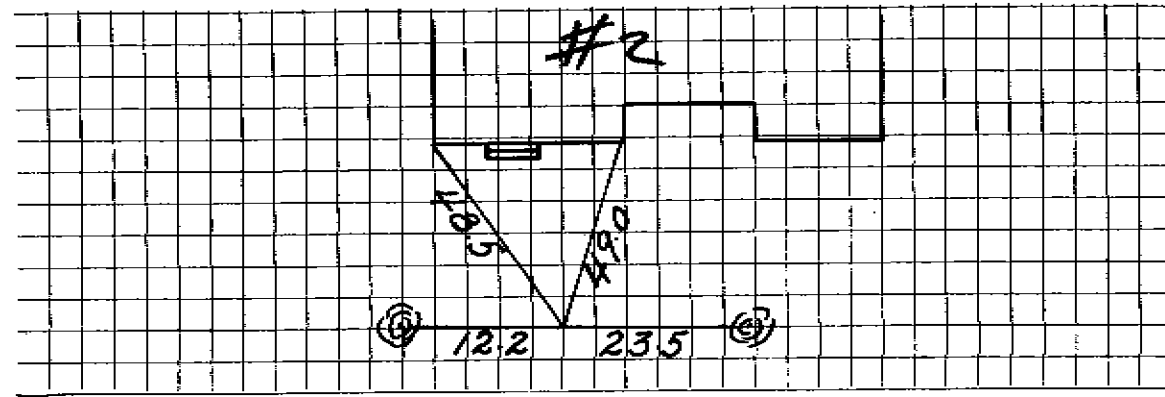

Connection made in _____ Street. Work completed _____ 19

Remarks: