




TOWN OF LEXINGTON — BOARD OF PUBLIC WORKS

**WATER DIVISION**

Sketch of Service Here  
# 21 FOREST ST.

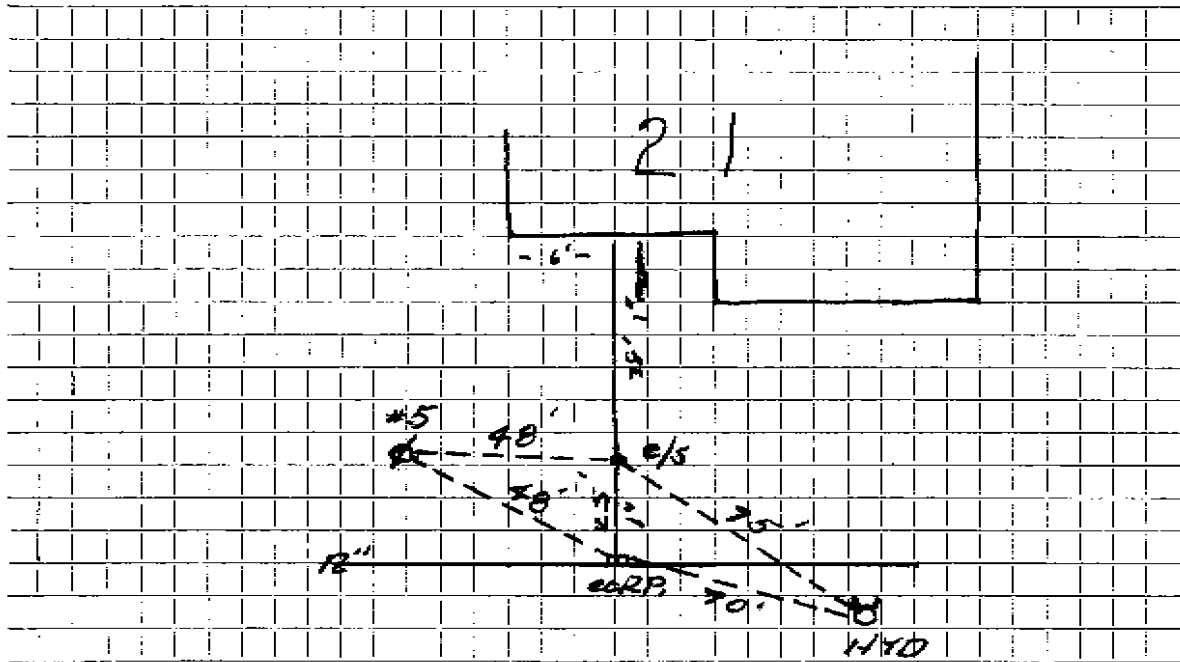

Connection made in FOREST Street. Work completed .....

Remarks: .....

.....

.....