

WATER SERVICE RECORD

Name

Service No.

Address 25 Forest Street

Location

~~Repair—Renewal—New Service~~ W.O.#1129. (outside).


Date	Material	Amount	Total	Date	Amount
8-1-'73	Labor 66.80			6/29/33	Supply by OWNER
8-17'73	" 45.98	\$112.78			
	20' 3/4" Copper Pipe @.60	12.00			
1	3/4 Corporation	9.57			
1	3/4 Curb Cock	11.32			
3	Ton Cold Patch	6.10			
2	Ton Top @8.00	16.00			
		\$167.77			
4 1/2	Hrs. Trucking				
2	Hrs. Town Shovel				
3/4	Hrs. Compressor				
1/2	Hr. Loader				
1	Hr. Pickup				
1	Hr. Roller				

DATE _____

TOWN OF LEXINGTON — BOARD OF PUBLIC WORKS

WATER DIVISION

Sketch of Service Here

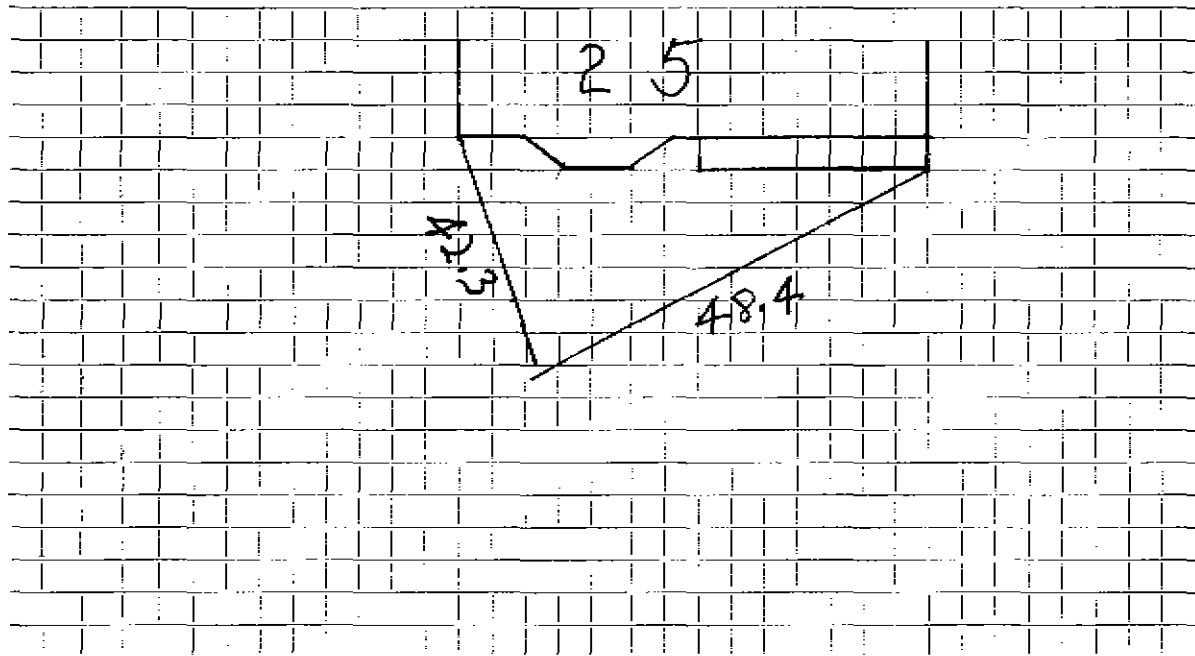

Connection made in Street. Work completed

Remarks:

.....

.....