

Name C. Henry Jackson

Service No. 186

Address 28 & 28A Forest Street

Lexington, Mass.

Location 28 & 28A Forest Street

Kind of Pipe

Size

Size of Main

~~Repair~~—Renewal—~~NEW SERVICE~~

Com. 11-6-50

Location

Date

Material

Amount

Total

Date

Amount

Aug. 23, '50

Labor

2 75

2 75

100' Overhead

28

12' - 3/4" Copper Tubing @.275

11 55

1 - 3/4" C x 1/2" I.W.H. S&W

3 29

Littlefield Shovel 2 1/2 hrs. @ 7.00

17 50

Trucking 1 hr. @.75

0 75

36 12

July 23, '50

No Charge

No Charge

No Charge

No Charge

Aug. 23, '50 Labor

9 25

10' - 3/4" Copper Tubing @.275

2 75

1 - 3/4" C Corp-cock

3 15

1 - 3/4" C x 3/4" C Curb-cock

3 85

1 - Box & Rod

3 35

1 - 1/2" Offset Tail Piece

42

1 - 1/2" Straight Tail Piece

42

Littlefield Shovel 2 hrs. @ 7.00

14 00

Trucking 1 hr. @.75

75

Patching 20 x 3

20 00

57 94

Labor

DATE _____

TOWN OF LEXINGTON—BOARD OF PUBLIC WORKS

WATER DIVISION

The undersigned applies for a supply of water at No. _____ St. and hereby agrees to comply with the rules and regulations as now, or at any future time, established by the Board of Selectmen.

Am't. of Estimate \$ _____


Owner _____

Am't. Paid \$ _____

Address _____

Builder _____

Sketch of Service Here

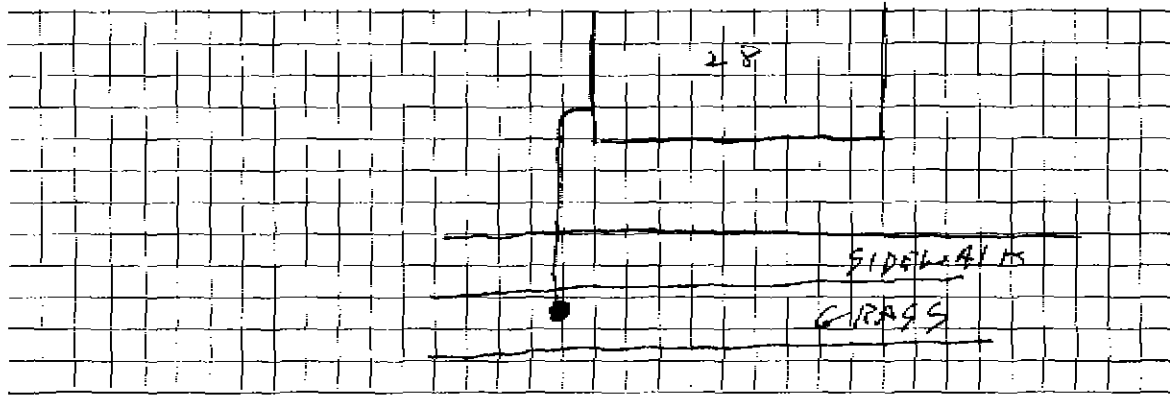

Connection made in _____ Street.

Work completed _____ 19

Remarks: