

Name Burgee B. Coffill

Service No. 44 739^L

Address 3 Forest Street

Lexington, Mass.

Location 3 Forest Street

Kind of Pipe

Size

Size of Main

~~Repair~~ - ~~Renewal~~ - ~~New Service~~

Location

Date

Material

Amount

Total

Date

Amount

Apr. 1, 1946

Labor

9 18

April 1 '46

Deposited

28 00

2

"

4 34

13 52

April 11 '46

Refunded

1 20

10% Overhead

1 35

23 91

25' - 3/4" Copper Tubing

4 40

1937

RENEWED MAIN TO CURB NEW MAIN

1 - 3/4" C x 1/2" I.P.H. Stop & Waste

3 59

1 - 2" I x 3/4" C Union (2 parts)

1 10

Trucking 1 hr. . . 75

75

23 71

Labor

DATE _____

TOWN OF LEXINGTON—BOARD OF PUBLIC WORKS

WATER DIVISION

The undersigned applies for a supply of water at No. _____ St. and hereby agrees to comply with the rules and regulations as now, or at any future time, established by the Board of Selectmen.

Am't. of Estimate \$ _____


Owner _____

Am't. Paid \$ _____

Address _____

Builder _____

Sketch of Service Here

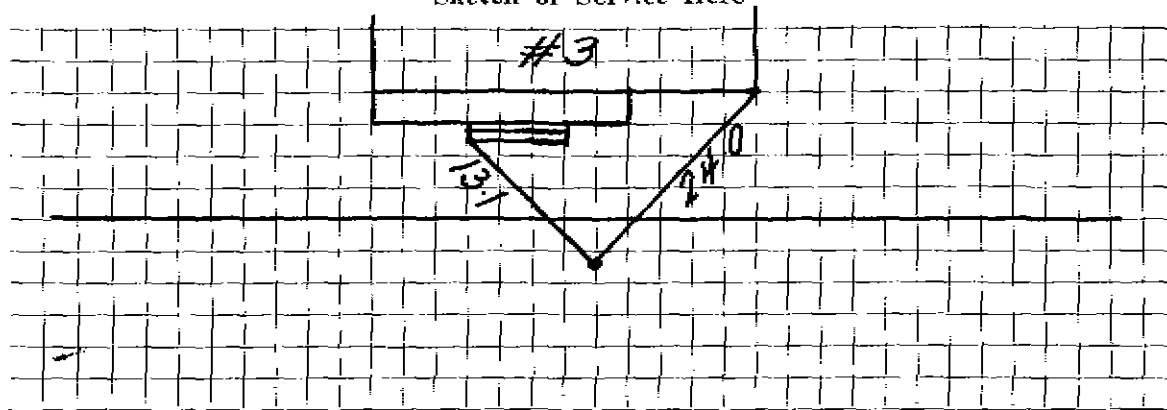

Connection made in _____ Street. Work completed _____ 19

Remarks: