

## WATER SERVICE RECORD

Name Louis L. Crone

Service No. 222

Address 30 Forest Street

Location 30 Forest St.

~~Repair~~ - ~~Renewal~~ - ~~New Service~~


Comm. 12/31/57

Date	Material	Amount	Total	Date	Amount	
11/29/57	Labor	21 57		10-7-57	Deposit	75 00
	10% overhead	2 16		12-31-57	Refund	23 54
			23 73			\$ 51 46
	35' 3/4" copper tubing @.37		12 95		NON CHARGE	
	1 3/4 Cx3/4 IWH stop & waste		4 96		1 3/4" straight tl. pc.	50
	1 1" brass close nipple		58	5-22-59	20' 3/4 Copper	
	1 1" x 3/4" 2 part union		1 24		1 3/4 Corp Cock	
	1 hr. town shovel @ 6.50		6 50		1 3/4 Corp Cock	
	2 hrs. trucking @.75		1 50		10x3' Patch	
			51 46			

DATE \_\_\_\_\_

TOWN OF LEXINGTON — BOARD OF PUBLIC WORKS  
WATER DIVISION

Sketch of Service Here **30**

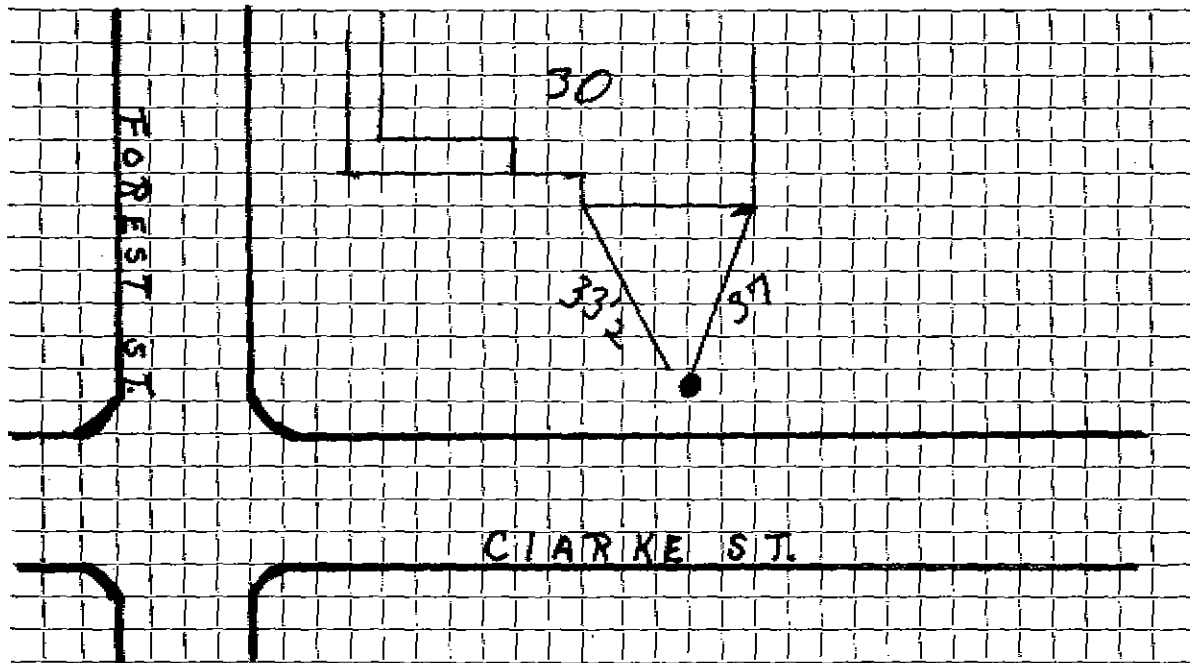

Connection made in ..... Street. Work completed .....

Remarks: .....

.....

.....