

WATER SERVICE RECORD

Name John Barry

Service No. 190

Address 34 Forest Street

Location Lexington

~~REPAIR~~ - Renewal - ~~NEW SERVICE~~ COM. 9/8/52

Date	Material	Amount	Total	Date	Material	Amount	Total
7/21/52	Labor	1 63					
	10% overhead	16	1 79	9-18-52	<i>to depart</i> <i>Paid</i>	21 21	
	45' - 3/4" copper tubing @ .326	14 67			<u>NON CHARGE</u>		
	1 - 3/4" Cx 1/8 I.W.H. stop & waste	4 00		7/21/52	Labor	1 63	
	1 - hr. trucking	75			20' - 3/4" copper tubing @ .326	6 52	
			21 21		1 - 3/4" C. corp-cock	4 33	
	TRENCH DUG BY OWNER				1 - 3/4" C. x 3/4" curb-cock	4 67	
					1 box and rod	4 68	
					1 - 3/8 offset tail piece	50	
					1 - 3/8 straight tail piece	50	
					1 hr. Littlefield shovel	7 00	
					1 hr. trucking	75	
					patching 15 x 3	15 00	
						45 58	


5
1

Amount

DATE _____

TOWN OF LEXINGTON — BOARD OF PUBLIC WORKS
WATER DIVISION

Sketch of Service Here

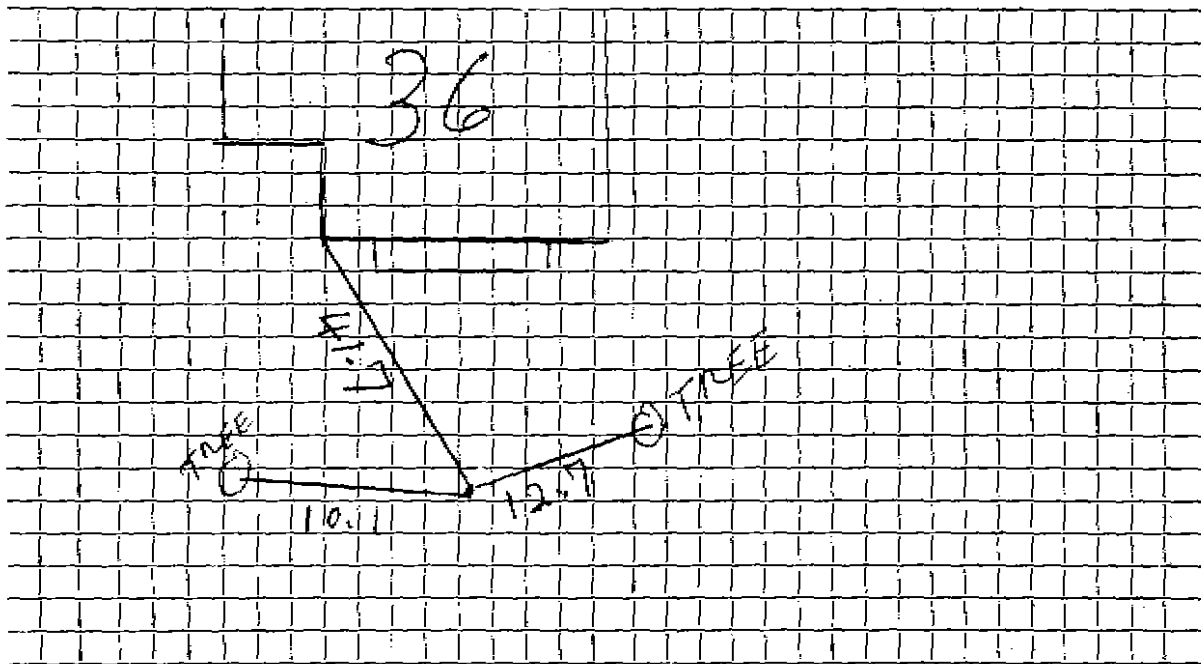

Connection made in Street. Work completed

Remarks:

.....

.....