




DATE 10-14-98

TOWN OF LEXINGTON — BOARD OF PUBLIC WORKS  
WATER DIVISION

Sketch of Service Here

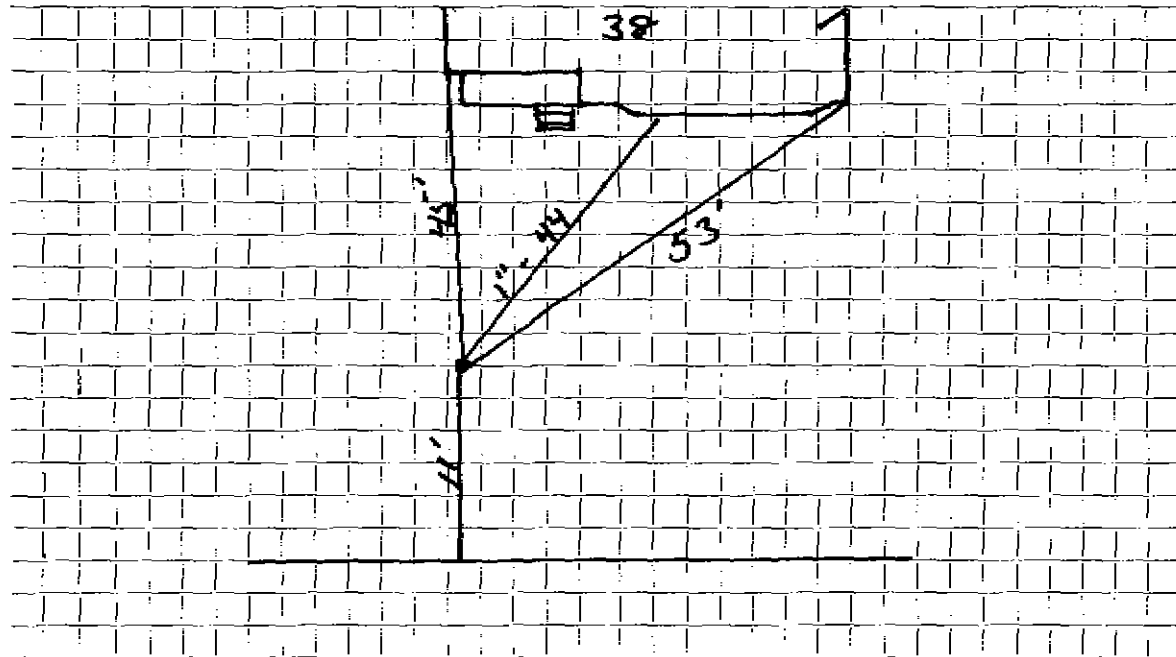

Connection made in ..... Street. Work completed 10-14-98

Remarks: Water Main 2 1/2' Below Gas Main

## WATER SERVICE RECORD

Name

Service No.

Address

38 Forest Street

Location

~~Repair—Renewal—New Service~~ W.O.#1896 (outside).


Date	Material	Amount	Total	Date	Amount
3-22-74	Labor	144.80			
4-1-'74	Labor	60.61	\$205.41		
22'	3/4" Copper Pipe @1.05		23.10		
1	3/4" Curb Cock		12.45		
1	1" Repair Clamp				
1	1" Coupling				
1	1" x 4" Nipple				
1/2	Ton Cold Patch				
1	6" x 8" Style 360 Repair Clamp				
1	15 x 9 Hot Top				
1	8 x 8 Hot Top				
5	Hrs. Truck				
2	Hrs. Town Shovel				
2	Hrs. Pickup				
1	Hr. Roller				
1/2	Hr. Loader				
1/2	Hr. Compressor				

DATE \_\_\_\_\_

TOWN OF LEXINGTON — BOARD OF PUBLIC WORKS

**WATER DIVISION**

Sketch of Service Here

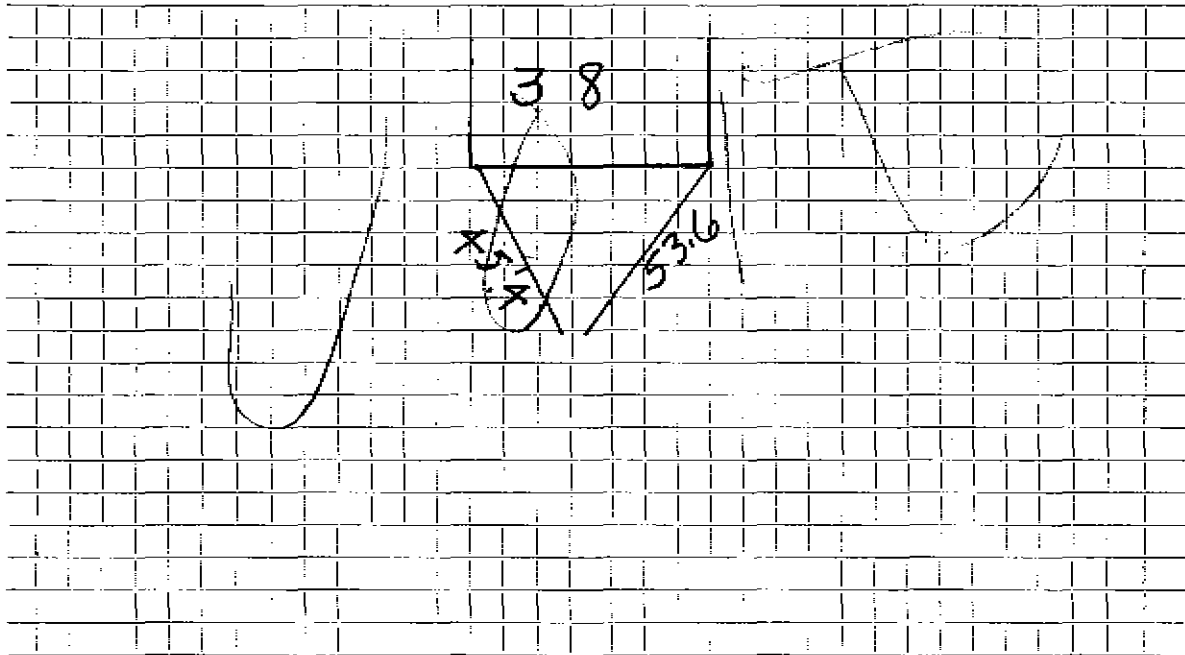

Connection made in ..... Street. Work completed .....

Remarks: .....

.....

.....