

Name William Mulvey
 Address 40 Forest Street
 Lexington, Mass.

Service No.

Location 40 Forest Street

Kind of Pipe RENEWAL
~~Repair~~ ~~Renewal~~ ~~New Service~~ Size Com. 6-14-49 Size of Main Location

Date	Material	Amount	Total	Date	Material	Amount
Apr. 27, '49	Labor	13 80		April 28 '49	Proposed	125 00
28	"	59 80	73 60	June 24 '49	Refunded	2 93
	10% Overhead		7 36		Non-Charge	122 07
	127' - 3/4" Copper Tubing @ .27	34 29		Apr. 29, '49	Labor	30 00
	1 - 3/4" C x 1/2" I.W.H, S&W	3 29		30	"	15 33
	2 - 3/4" C x 3/4" C Unions (3pts)	2 78		11' - 3/4" Copper Tubing @ .27		2 97
	Trucking 1 hr. @ .75		75	1 - 3/4" C Corp-cock		3 15
			122 07	1 - 3/4" C x 3/4" C Curb-cock		3 85
				1 - Box & Rod		3 95
				1 - 1/2" Straight Tail Piece		37
				1 - 1/2" Offset Tail Piece		37
				Trucking 1 hr. @ .75		75
	Labor			Patching 11 x 3		11 00
						71 74

DATE _____

TOWN OF LEXINGTON - BOARD OF PUBLIC WORKS

WATER DIVISION

The undersigned applies for a supply of water at No..... St. and hereby agrees to comply with the rules and regulations as now, or at any future time, established by the Board of Selectmen.

Am't of Estimate \$.....

Owner


Am't Paid \$.....

Address

Builder

.....

Sketch of Service Here

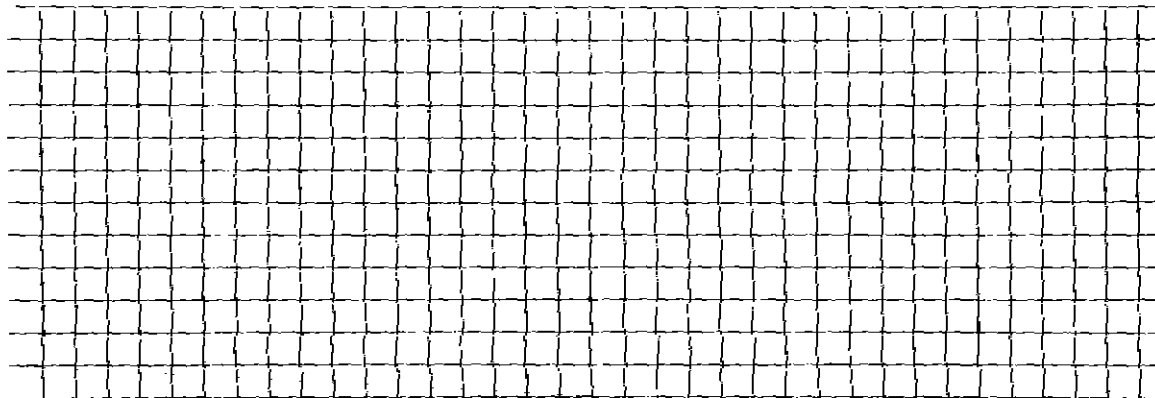

Connection made in Street.

Work completed19

Remarks: