

Name William Mulvey

Service No.

Address 42 Forest Street

Lexington, Mass.

Location 42 Forest Street

Kind of Pipe

Size

Size of Main

~~REPAIR~~ - Renewal - ~~NEW SERVICE~~

Com. 7-5-49

Location

Date	Material	Amount	Total	Date	Amount
	89' - 3/4" Copper Tubing @.27		24 03	April 25 '49	25 00
	1 - 3/4" C x 3/4" I.W.N. S&W		3 29	July 14 '49	5 02
	1 - 3/4" C x 3/4" C Union		1 39		30 02
	2 - 3/4" Close Nipples		88		
	1 - 3/4" Elbow		43		
			30 02		
				11' - 3/4" Copper Tubing @.27	2 97
				1 - 3/4" C Corp-cock	3 15
				1 - 3/4" C x 3/4" C Curb-cock	3 85
				1 - Box & Rod	3 95
					13 92
	Labor				

Deposited
Paid

Non-Charge

DATE _____

TOWN OF LEXINGTON - BOARD OF PUBLIC WORKS

WATER DIVISION

The undersigned applies for a supply of water at No..... St. and hereby agrees to comply with the rules and regulations as now, or at any future time, established by the Board of Selectmen.

Am't of Estimate \$.....

Owner


Am't Paid \$.....

Address

Builder

.....

Sketch of Service Here

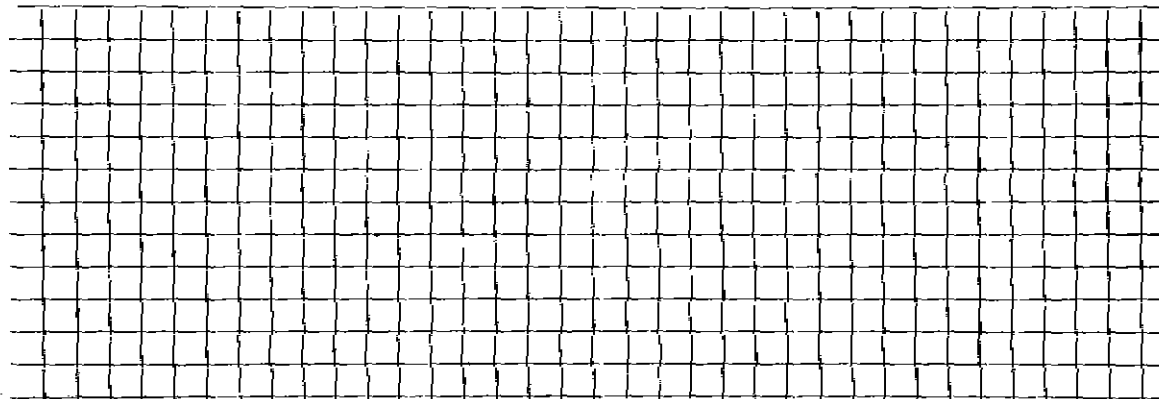

Connection made in Street.

Work completed19

Remarks: