

Name Raymond L. Nickerson

Service No. ~~10~~ 968

Address 43 Forest Street  
Lexington 73, Mass.

Location 43 Forest Street

Kind of Pipe

Size

Size of Main

~~Repair—Renewal—New Service~~

Location

Date 1944	Material	Amount	Total	Date		Amount
Sept. 8, '44	Labor	33 85		Sept 5 '44	Deposited	100 00
9, '44	"	<u>16 50</u>	50 35	Oct. 19 '44	Refunded	<u>38 63</u>
	10% Overhead		5 04		Non-charge	61 37
	Truck 1 hr. @.75		75		Labor	15 00
	1 W.H. Stop & Waste		2 53		Comp. 2 hrs.	
	6 - $\frac{3}{4}$ " Copper Couplings @.45		<u>2 70</u>	1 - $\frac{3}{4}$ " Curb Cock		
			61 37	1 - $\frac{3}{4}$ " Adapter		
				24' - $\frac{3}{4}$ " Copper Tubing		
				1 Box and Rod		
				Patching		
	Furnished copper tubing from curb to house					
	Labor					

Hadley Press, Inc., Lexington

# TOWN OF LEXINGTON—BOARD OF PUBLIC WORKS WATER DIVISION

The undersigned applies for a supply of water at No. \_\_\_\_\_ St. and hereby agrees to comply with the rules and regulations as now, or at any future time, established by the Board of Selectmen.

Am't. of Estimate \$ \_\_\_\_\_


Owner \_\_\_\_\_

Am't. Paid \$ \_\_\_\_\_

Address \_\_\_\_\_

Builder \_\_\_\_\_

Sketch of Service Here

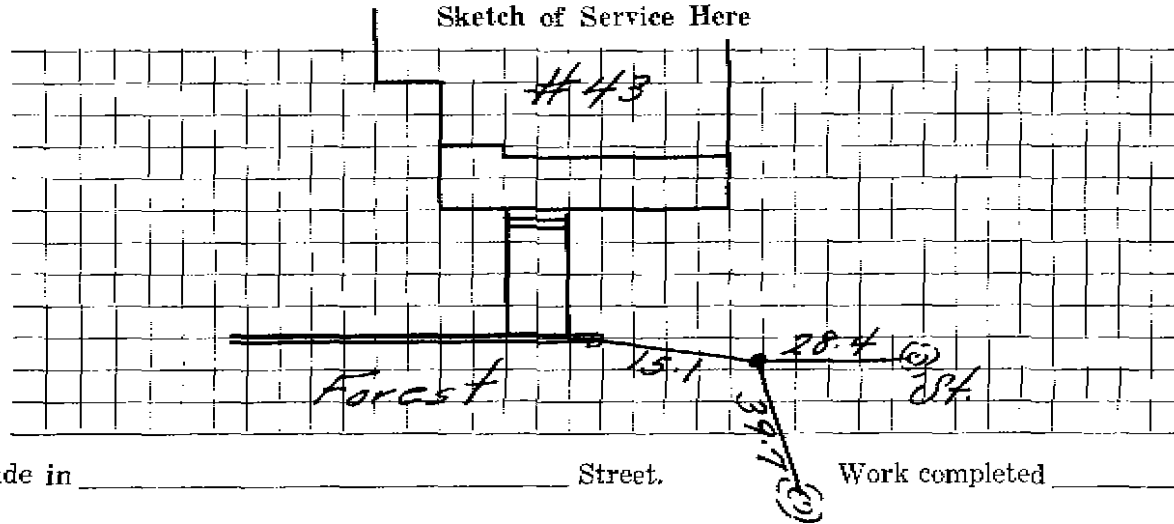

Connection made in \_\_\_\_\_ Street.

Work completed \_\_\_\_\_ 19

Remarks: