
Na	me Ma	rs. Whalen	WATER SERVICE RECORD				Service No.			
	dress eation	44 Forest Street								
		Repeir 1909-X44XXXXXXXXXXXXXXXXXXXXXXXXXXXXXXXXX	Kee #4046							
Date		Material	Amount	Total	Date			Amount		
4/16/82	34'	3/4" copper tubing								
		3/4" Curb Cock								
		Box & Rod	<u> </u>							
		3/4" Wheel Handle			<u> </u>		RENEWAL W.O. #102			
<del></del>		· •			6/2/83	20'	3/4" Copper	<u> </u>		
<u></u>						1_	Adapter 3/4" to 5/8" Le	ad		
<del>-</del>				!	 					
<u>-</u>		· · · · · · · · · · · · · · · · · · ·	·	ļ						
- · . <u> </u>						· <u> </u>				
	<del>-</del> -		,		<u> </u>					
			·							
	<u>'</u>	· 		<u> </u>	# ;					
- <del></del> -		<u> </u>			· <del></del>		<u> </u>	· 		
<u> </u>		<u>:</u>	<u> </u>							
	<u> </u>	<u> </u>		<u>.</u>				<u> </u>		
				i	,			i		
	_ <del>:</del>									
		i	:	!	T			— !—		

DATE
------

## TOWN OF LEXINGTON - BOARD OF PUBLIC WORKS

## WATER DIVISION

## Sketch of Service Here

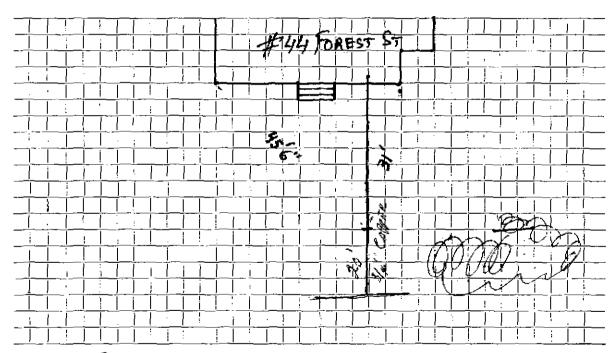

		FOR A SST	C			
Connection	made in	TOP REST	マチー	 -	-	Stro
Countection	made m	N. T. S. W. C. C. C. C. C. C.		 		MITTE

Work completed .....

Remarks: WATER & SEWER IN SAME TREMEN.